

ADDENDUM THREE

Addendum Three (AD.03) to the drawings and specifications prepared by Gibraltar Design for **Early Learning Center (ELC) and Alternative Learning Center (ALC) Additions and Renovations** for Tippecanoe School Corporation, Lafayette, Indiana.

All Contractors bidding on this project shall read all of the items covered below and shall comply with all of the requirements as set forth, including any necessary refinements or additions generated by this Addendum and required by the intent of the original contract documents. All Contractors shall acknowledge on their bid form that they have received this Addendum and previous Addendums One and Two and include the appropriate content of same within their bid proposal.

SPECIFICATIONS

1. Specification Section 06 20 00

Rough Carpentry

- A. Add paragraph 2.7 to read:
 - "2.7 Slider Window Unit
 - A. Provide and install aluminum slider window, Boyd Aluminum Manufacturing Window, Model Series 700, horizontal sliding unit, or approved equal.
 - B. Install slider window into gypsum board opening refer to drawings for location and size required."

2. Specification Section 08 41 00

Aluminum Storefronts

- A. Paragraph 2.6 A2, revise text to read:
 - "2. Early Learning Center: 1 mil thick, 70 percent Kynar 500 or Hylar 5000 type finish, over minimum 0.2 mil baked-on modified epoxy primer; of color to match medium bronze anodized finish selected by the Architect."

3. Specification Section 08 71 00

Door Hardware – Early Learning Center

A. Paragraph 3.05.D revise Hardware Set #18 to read:



Hardware Group No. 18

A-139A

Provide QTY	e each P	R door(s) with the following: DESCRIPTION	CATALOG NUMBER	FINISH	MFR
2	EA	CONT. HINGE	112XY EPT	628	IVE
2	EA	POWER TRANSFER	EPT10	689	VON
1	EA	KEYED REMOVABLE	KR4954 STAB	689	VON
•	L/ \	MULLION	1111-100-1011	000	V 011
1	EA	ELEC PANIC HARDWARE	CDSI-LXRX-LC-99-NL-OP- 110MD	626	VON
1	EA	ELEC PANIC HARDWARE	CDSI-RX-99-EO	626	VON
1	EA	MULLION STORAGE KIT	MT54	689	VON
3	EA	MORTISE CYL HOUSING (SFIC)	80-110 (W/ DISP CONST CORE)	626	SCH
1	EA	RIM CYL HOUSING (SFIC)	80-159 (W/ KEYED CONST CORE)	626	SCH
4	EA	PERMANENT CORE	MATCH EXISTING KEY SYSTEM	626	
1	EA	ELECTRIC STRIKE	6300 FSE 12/24 VAC/VDC	630	VON
2	EA	90 DEG OFFSET PULL	8190EZHD 12" O	630-	IVE
				316	
2	EA	SURFACE CLOSER	4040XP SCUSH	689	LCN
2	EA	MOUNTING PLATE	4040XP-18PA AS REQ'D	689	LCN
2	EA	CUSH SHOE SUPPORT	4040XP-30 AS REQ'D	689	LCN
2	EA	BLADE STOP SPACER	4040XP-61 AS REQ'D	689	LCN
1	EA	MULLION SEAL	8780NBK	BK	ZER
1	EA	WEATHER STRIPPING	BY DOOR/FRAME SUPPLIER		
2	EA	DOOR SWEEP	39A	Α	ZER
1	EA	THRESHOLD	655A	Α	ZER
1	EA	FIRST RESPONDER CREDENTIAL READER	BY ACCESS CONTROL PROVIDER		
1	EA	CREDENTIAL READER	BY ACCESS CONTROL PROVIDER		
2	EA	DOOR CONTACT	679-05HM	BLK	SCE
1	EA	POWER SUPPLY	PS904 900-2RS [COORDINATE WITH ACCESS CONTROL		VON
			PROVIDER]		
1	EA	DIAGRAM	ELEVATION		DLR
1	EA	DIAGRAM	POINT TO POINT		DLR
	OF	PERATION: DOOR NORMALL	Y CLOSED AND LOCKED. DOORS	CAN BE I	LEFT

OPERATION: DOOR NORMALLY CLOSED AND LOCKED. DOORS CAN BE LEFT UNLOCKED AS PROGRAMMED BY ACCESS CONTROL.

LOCKED HOURS: VALID CREDENTIAL/FIRST RESPONDER CREDENTIAL MOMENTARILY RELEASES ELECTRIC STRIKE ALLOWING ENTRY. DOOR CONTACT TO MONITOR DOOR



POSITION. RX SWITCH IN EXIT DEVICE PUSH PAD SHUNTS DOOR CONTACTS FOR VALID EGRESS. FREE EGRESS AT ALL TIMES.

4. Specification Section 12 32 16 Plastic Laminate Casework

A. Change paragraph 2.2.I.6.a1 to read, "Polycarbonate".

5. Specification Section 22 31 00 Domestic Water Softeners

A. Revise paragraph 2.01.D.1 to read as follows: "Softener tank shall be of sufficient size to allow for a proper freeboard space above the resin bed for adequate expansion of the resin during backwashing.

6. Specification Section 23 00 07 Mechanical Insulation

- A. Revise paragraph 2.04.A.3 to read as follows: Supply Air Ductwork located in attic spaces shall be internally lined and externally insulated.
- B. Revise paragraph 2.04.A.4 to read as follows: Return Air Ductwork located in attic space shall be internally lined and externally insulated.

DRAWINGS

Early Learning Center Drawings

7. Sheet A-101

- A. Refer to revised, full-size drawing, included in this Addendum, for revisions.
 - 1. Modify swings of doors A-107, A117A, A-124, A-135, A-138, A-140, and A-143.

8. Sheet A-710

- A. Refer to revised, full-size drawing, included in this Addendum, for revisions.
 - 1. Shower Threshold Detail: Change marble threshold to solid surface.

9. Sheet EL101

A. Refer to revised, full-size drawing, included in this Addendum, for revisions.

10. Sheets EP101 and EP102

A. Refer to revised, full-size drawing, included in this Addendum, for revisions.

11. Sheets E501 and E502

A. Refer to revised, full-size drawing, included in this Addendum, for revisions.

12. Sheet E601

A. Refer to revised, full-size drawing, included in this Addendum, for revisions.

Alternative Learning Center Drawings

13. Sheet A-601

- A. Refer to revised, full-size drawing, included in this Addendum, for revisions.
 - 1. Change Door A-124B to Type 2 Door.



14. Sheet A-710

- A. Refer to revised, full-size drawing, included in this Addendum, for revisions.
 - 1. Shower Threshold Detail: Change marble threshold to solid surface.

15. Sheet E101


A. Refer to revised, full-size drawing, included in this Addendum, for revisions.

16. Sheet E501

A. Refer to revised, full-size drawing, included in this Addendum, for revisions.

Pages 1 through 4, inclusive, and Twelve (12) Full-Size Drawings, constitute the total makeup of **Addendum Three**.



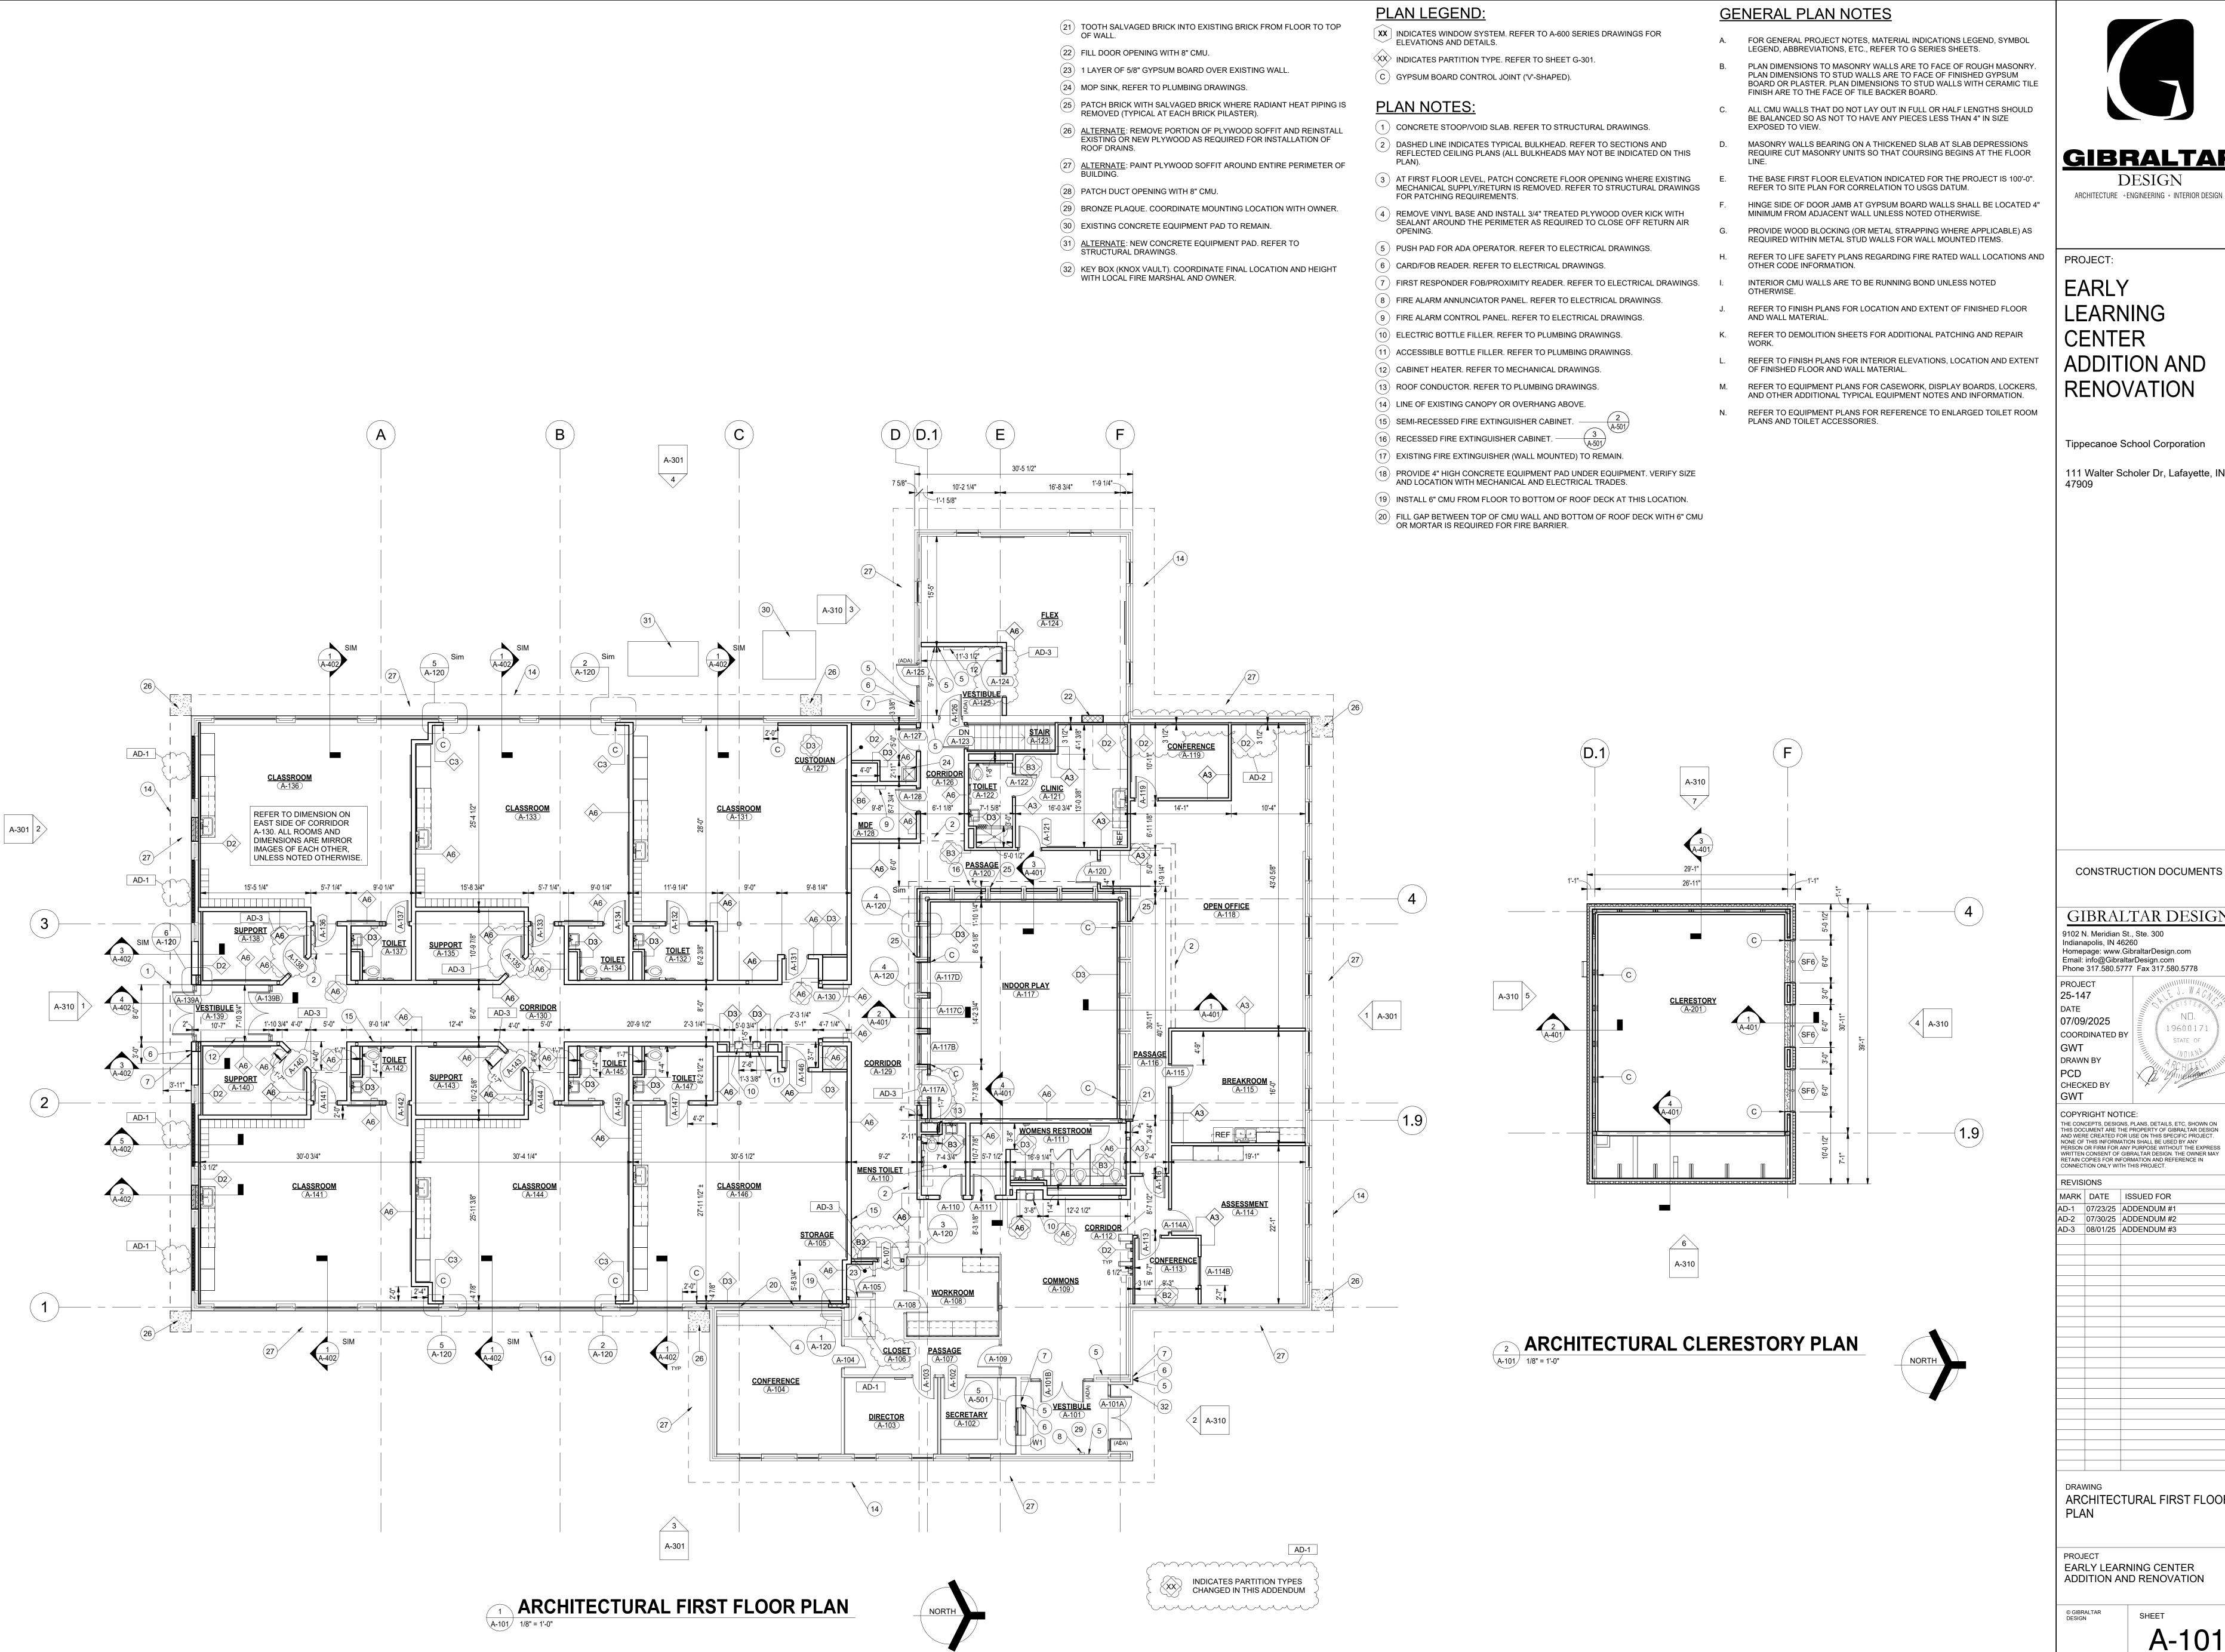

GIBRALTAR DESIGN

EARLY LEARNING **ADDITION AND**

Tippecanoe School Corporation 111 Walter Scholer Dr, Lafayette, IN

CONSTRUCTION DOCUMENTS

GIBRALTAR DESIGN 9102 N. Meridian St., Ste. 300 Indianapolis, IN 46260 Homepage: www.GibraltarDesign.com Email: info@GibraltarDesign.com Phone 317.580.5777 Fax 317.580.5778

COORDINATED BY

19600171


PERSON OR FIRM FOR ANY PURPOSE WITHOUT THE EXPRESS WRITTEN CONSENT OF GIBRALTAR DESIGN. THE OWNER MAY RETAIN COPIES FOR INFORMATION AND REFERENCE IN CONNECTION ONLY WITH THIS PROJECT.


MARK DATE ISSUED FOR AD-1 07/23/25 ADDENDUM #1 AD-2 07/30/25 ADDENDUM #2


ARCHITECTURAL FIRST FLOOR

EARLY LEARNING CENTER ADDITION AND RENOVATION


A-101

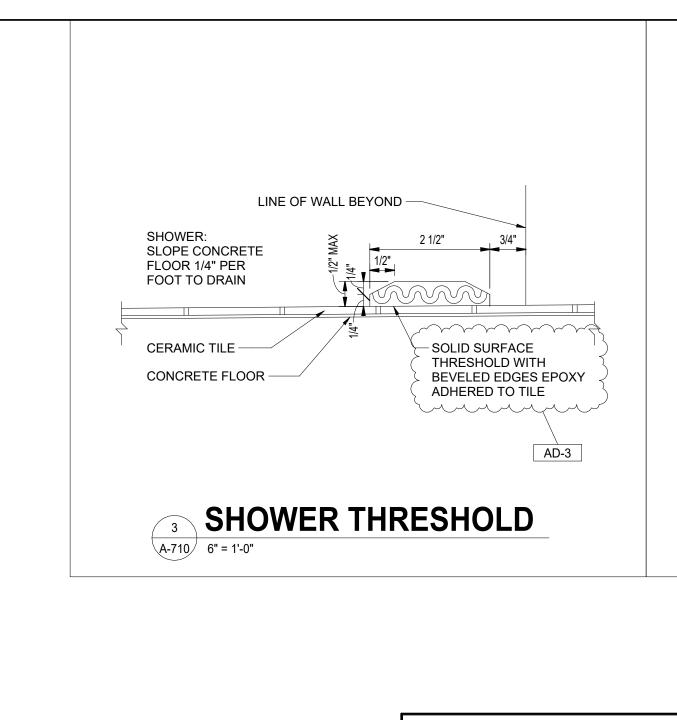

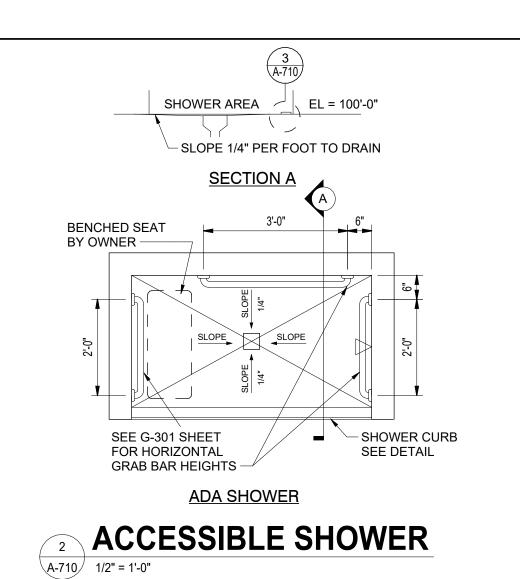


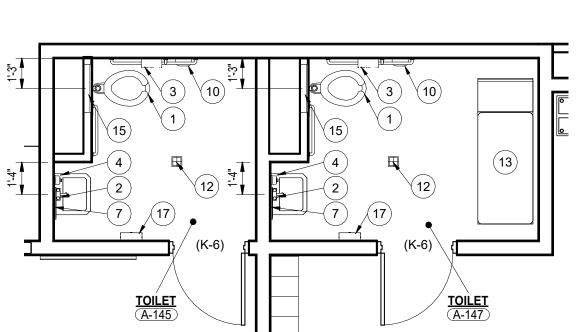


ENLARGED CLASSROOM TOILET ROOM PLAN A-710 1/4" = 1'-0"

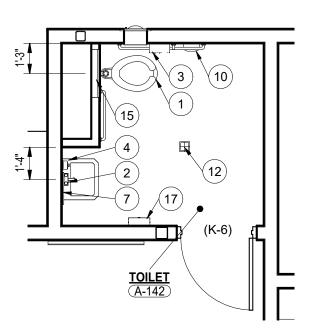

ENLARGED CLASSROOM TOILET ROOM PLAN A-710 1/4" = 1'-0"

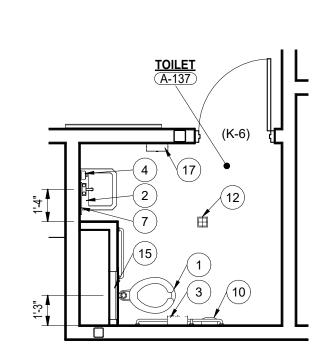


ENLARGED CLASSROOM TOILET ROOM PLAN

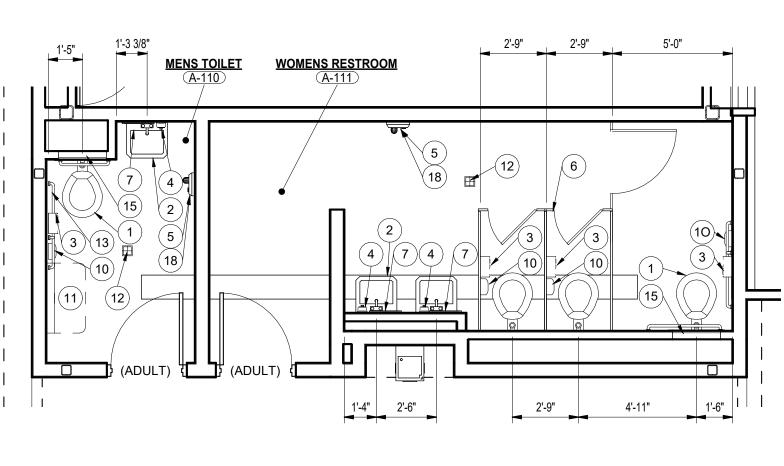

ENLARGED CLINIC TOILET ROOM PLAN

ENLARGED RESTROOM PLAN

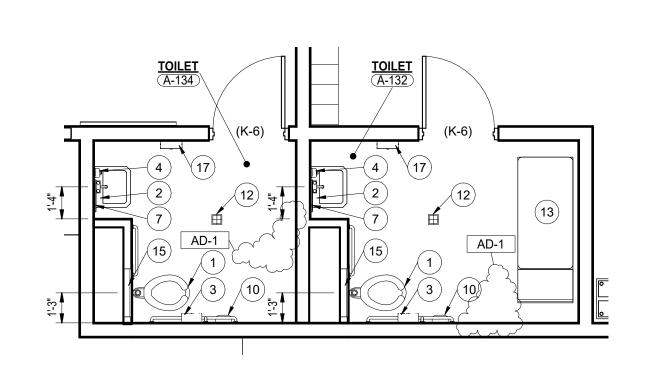


ENLARGED CLASSROOM TOILET ROOM PLAN


GENERAL RESTROOM NOTES:

- A. FOR GENERAL PROJECT NOTES, MATERIAL INDICATIONS LEGEND, SYMBOL LEGEND, ABBREVIATION, ETC., REFER TO SHEET G-301.
- B. DEPTH OF ALL TOILET ENCLOSURES SHALL BE A MINIMUM OF 5'-0" CLEAR INSIDE DIMENSION UNLESS NOTED OTHERWISE.
- C. REFER TO PLUMBING DRAWINGS FOR FIXTURE TYPES.
- D. REFER TO PLUMBING DRAWINGS FOR FLOOR DRAIN LOCATIONS. E. COORDINATE HEIGHT OF GRAB BAR WITH TANK ON FLUSH VALVE OF WALL
- MOUNTED WATER CLOSET. F. INSTALL LAVATORIES AND URINALS AT 2'-6" ON CENTER MINIMUM UNLESS NOTED
- G. REFERENCE FINISH PLANS FOR FINISH INFORMATION.
- H. FOR MOUNTING HEIGHTS REFER TO SHEET G-301


PLAN NOTES:


- 1 ACCESSIBLE FACILITIES. (1) (2) ACCESSIBLE FIXTURE (LAVATORY/URINAL). SEE PLUMBING DRAWINGS.
- (3) TOILET PAPER HOLDER. (CFCI) (4) SOAP DISPENSER. (OFCI)
- (5) AUTOMATIC ELECTRIC HAND DRYER. REFER TO ELECTRICAL DRAWINGS FOR POWER CONNECTION.
- (6) TOILET PARTITION. 7) 1'-4" W.x.2'-6" H.MIRBOR AD-1
- (8) NOT USED
- 9 SHOWER ROD AND CURTAIN (10) FEMININE NAPKIN DISPOSAL.
- (11) BABY CHANGING TABLE.
- (12) FLOOR DRAIN. REFER TO PLUMBING DRAWINGS. (13) CHANGING TABLE BY OWNER.
- (14) ACCESSIBLE SHOWER.
- (15) 24"x24" ACCESS PANEL WITH TOP AT 5'-4" ABOVE FLOOR (16) SHOWER THRESHOLD.
- (17) PAPER TOWEL DISPENSER. (OFCI)
- (18) INSTALL WALL SPLASH GUARD BELOW ELECTRIC HAND DRYER. MOUNT TOP 3"

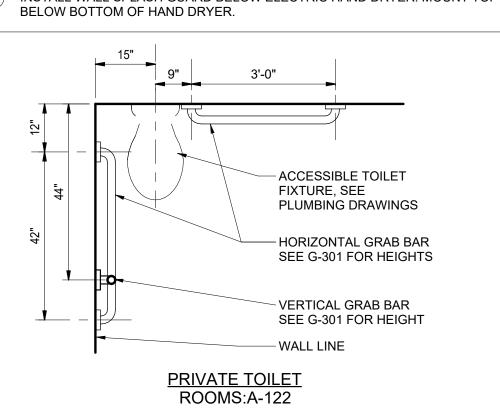

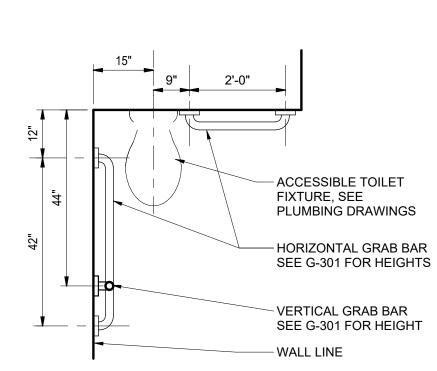

PRIVATE TOILET ROOMS: A-132, A-134, A-137, A-142, A-145, A-147

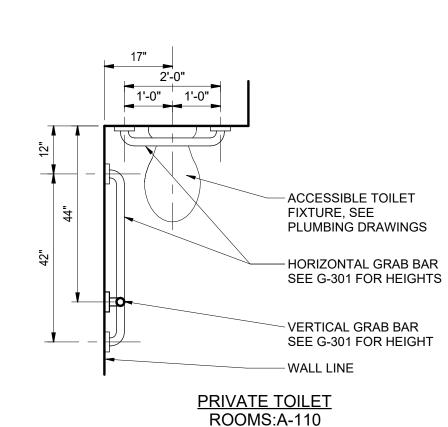

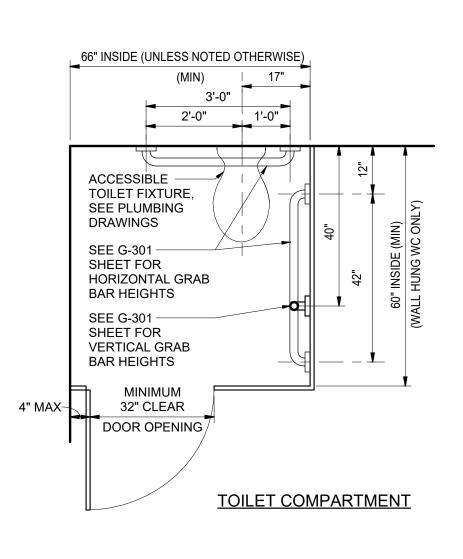





PROJECT: **EARLY** LEARNING

CENTER ADDITION AND RENOVATION

Tippecanoe School Corporation

111 Walter Scholer Dr, Lafayette, IN

CONSTRUCTION DOCUMENTS

GIBRALTAR DESIGN 9102 N. Meridian St., Ste. 300

Indianapolis, IN 46260 Homepage: www.GibraltarDesign.com Email: info@GibraltarDesign.com Phone 317.580.5777 Fax 317.580.5778

25-147 07/09/2025 19600171 **COORDINATED BY** GWT DRAWN BY RGH CHECKED BY

GWT **COPYRIGHT NOTICE:** THE CONCEPTS, DESIGNS, PLANS, DETAILS, ETC, SHOWN ON THIS DOCUMENT ARE THE PROPERTY OF GIBRALTAR DESIGN AND WERE CREATED FOR USE ON THIS SPECIFIC PROJECT. NONE OF THIS INFORMATION SHALL BE USED BY ANY PERSON OR FIRM FOR ANY PURPOSE WITHOUT THE EXPRESS WRITTEN CONSENT OF GIBRALTAR DESIGN. THE OWNER MAY RETAIN COPIES FOR INFORMATION AND REFERENCE IN CONNECTION ONLY WITH THIS PROJECT.

REVISIONS MARK DATE ISSUED FOR

AD-1 07/23/25 ADDENDUM #1 AD-3 08/01/25 ADDENDUM #3

ENLARGED TOILET ROOM EQUIPMENT PLANS

PROJECT EARLY LEARNING CENTER ADDITION AND RENOVATION

© GIBRALTAR DESIGN

A-710


A-710 1/4" = 1'-0"

GENERAL NOTES

- UNLESS OTHERWISE NOTED. EXTERIOR LIGHTING WITH NORMAL CIRCUIT TAG SHALL BE ROUTED TO EXISTING LIGHTING BRANCH CIRCUITS SERVING EXISTING EXTERIOR LIGHTING AND EXISTING TIME CLOCK AND CONTACTORS. VERIFY TEACHING SURFACE WITH OWNER'S REPRESENTATIVE IN FIELD PRIOR
- TO INSTALLATION AND ADJUST SWITCHING TO PROPERLY ILLUMINATED TEACHING SURFACE. CAREFULLY COORDINATE FINAL SWITCHING WITH FINAL FURNITURE PLANS AND TEACHING WALL LOCATIONS.
- CIRCUITS WITH AN 'E' PREFIX INDICATES FEED FROM THE EMERGENCY GENERATOR PANEL. CIRCUITS WITH AN 'S' PREFIX INDICATES FEED FROM THE EMERGENCY STANDBY PANEL.

SHEET NOTES

REMOVE EXISTING FLUORESCENT LAMPS AND BALLASTS. PROVIDE AND INSTALL NEW T8 LED RETROFIT TUBES (QTY 16) COMPATIBLE WITH NEW LIGHTING CONTROLS. COORDINATE AND VERIFY EXISTING CONDITIONS AND SYSTEM REQUIREMENTS PRIOR TO PROCUREMENT AND INSTALLATION. COLOR TEMP TO MATCH NEW LIGHTING FIXTURES.

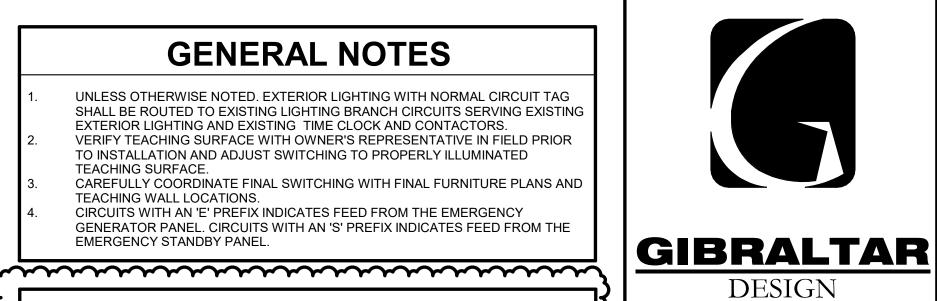


ARCHITECTURE • ENGINEERING • INTERIOR DESIGN (219) 924-8400

PROJECT:

EARLY LEARNING CENTER ADDITION AND RENOVATION

Tippecanoe School Corporation

111 Walter Scholer Dr, Lafayette, IN 47909

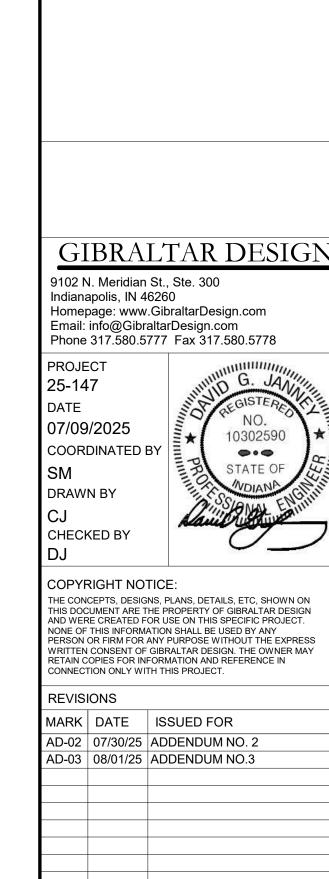





© GIBRALTAR DESIGN

FLOOR PLAN

PROJECT

EL101

ELECTRICAL LIGHTING FIRST

EARLY LEARNING CENTER ADDITION AND RENOVATION

GENERAL NOTES

1. EXISTING MECHANICAL EQUIPMENT TO BE DEMOLISHED. REMOVE EXISTING WIRING BACK TO EXISTING BRANCH PANEL. REFER TO MECHANICAL CONNECTION SCHEDULE FOR NEW CIRCUITING AND WIRING.
2. 20A 120-VOLT RECEPTACLES SHALL BE TAMPER RESISTANT IN ALL CLASSROOMS, CORRIDORS, RESTROOMS AND INDOOR PLAY AREAS.

SHEET NOTES

NEW RECEPTACLES AND DEVICES IN THIS SPACE SHALL BE INSTALLED IN EXISTING WOOD PANELING WALLS. CONTRACTOR SHALL REMOVE SECTION OF WOOD PANELING AND CUT OPENING IN WALL AS REQUIRED TO RUN POWER AND LOW VOLTAGE CONCEALED AS INDICATED. REINSTALL WOOD PANELING, COMPLETE AS REQUIRED.



GIBRALTAF

DESIGN

ARCHITECTURE • ENGINEERING • INTERIOR DESIGN

PROJECT:

EARLY
LEARNING
CENTER
ADDITION AND
RENOVATION

Tippecanoe School Corporation

111 Walter Scholer Dr, Lafayette, IN 47909

GIBRALTAR DESIGN

Indianapolis, IN 46260
Homepage: www.GibraltarDesign.com
Email: info@GibraltarDesign.com
Phone 317.580.5777 Fax 317.580.5778

9102 N. Meridian St., Ste. 300

PROJECT
25-147
DATE
07/09/2025
COORDINATED BY
SM
DRAWN BY

CJ
CHECKED BY
DJ

COPYRIGHT NOTICE:
THE CONCEPTS, DESIGNS, PLANS, DETAILS, ETC, SHOW THIS DOCUMENT ARE THE PROPERTY OF GIBRALTAR DE

THE CONCEPTS, DESIGNS, PLANS, DETAILS, ETC, SHOWN ON THIS DOCUMENT ARE THE PROPERTY OF GIBRALTAR DESIGN AND WERE CREATED FOR USE ON THIS SPECIFIC PROJECT. NONE OF THIS INFORMATION SHALL BE USED BY ANY PERSON OR FIRM FOR ANY PURPOSE WITHOUT THE EXPRESS WRITTEN CONSENT OF GIBRALTAR DESIGN. THE OWNER MAY RETAIN COPIES FOR INFORMATION AND REFERENCE IN CONNECTION ONLY WITH THIS PROJECT.

REVISIONS

MARK DATE ISSUED FOR

AD-02 07/30/25 ADDENDUM NO

AD-02 07/30/25 ADDENDUM NO. 2 AD-03 08/01/25 ADDENDUM NO.3


DRAWING
ELECTRICAL POWER FIRST


PROJECT
EARLY LEARNING CENTER
ADDITION AND RENOVATION


© GIBRALTAR


FLOOR PLAN

EP101

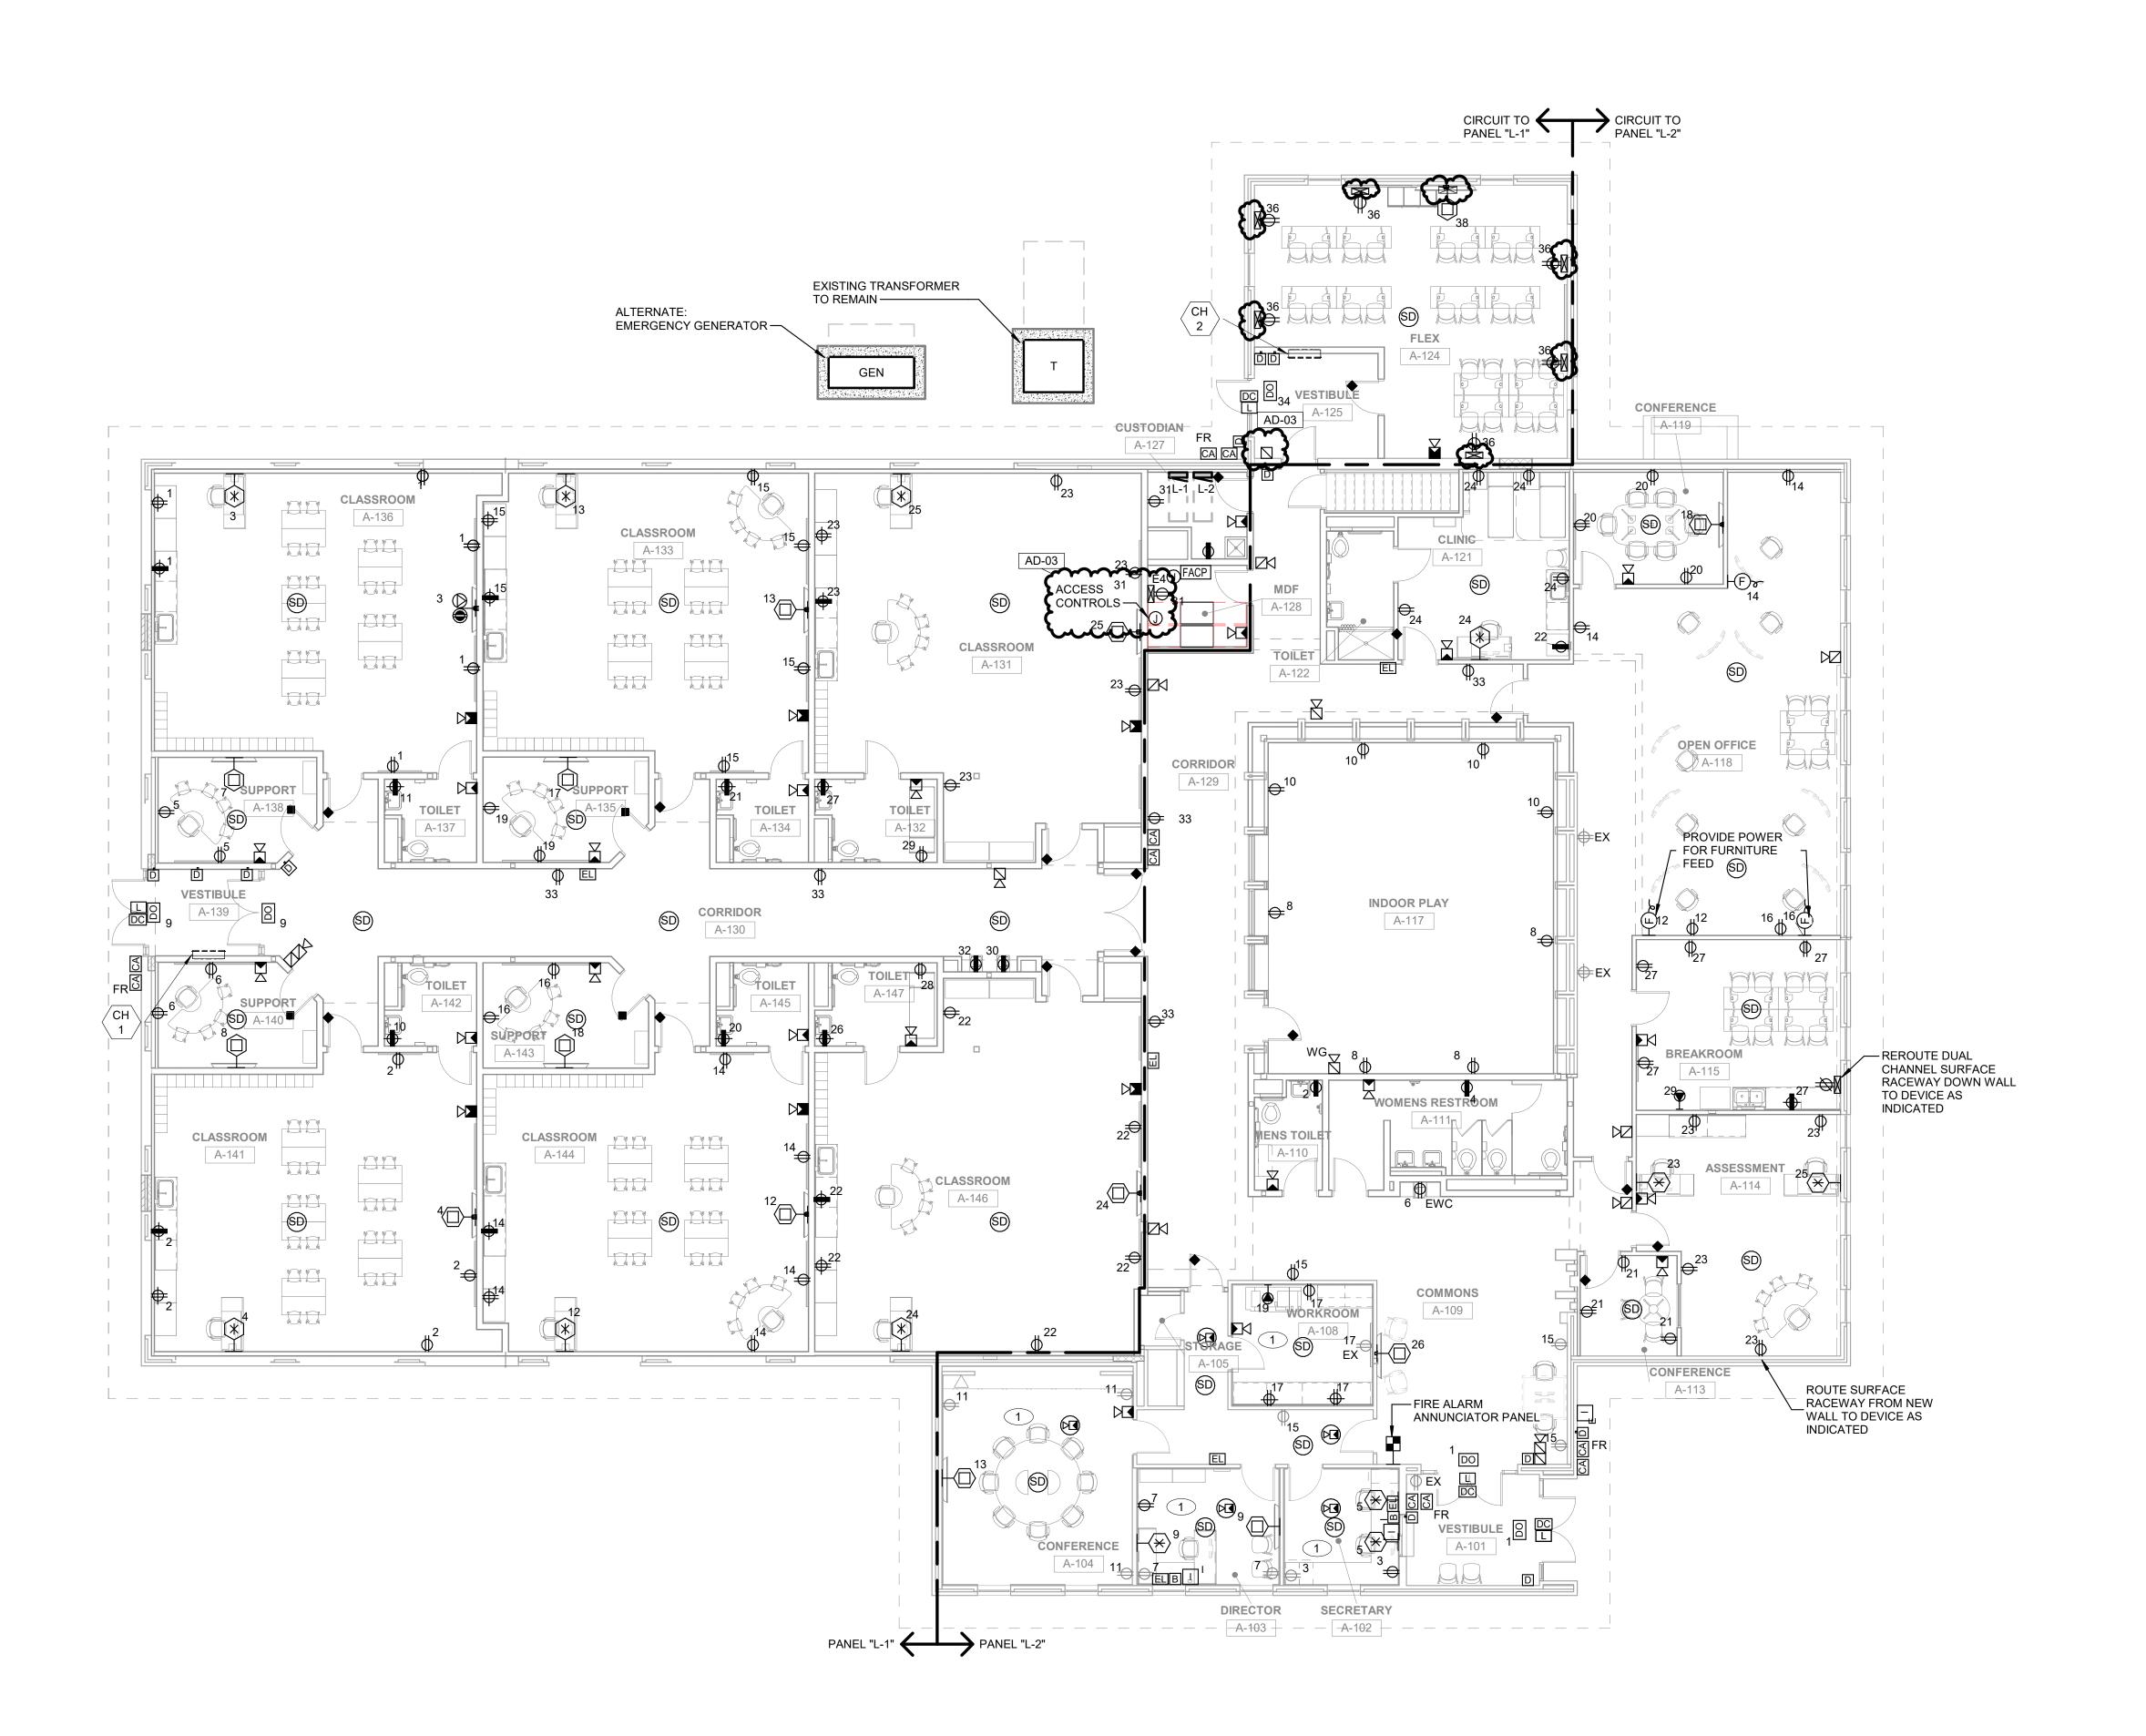

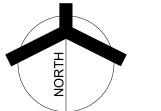

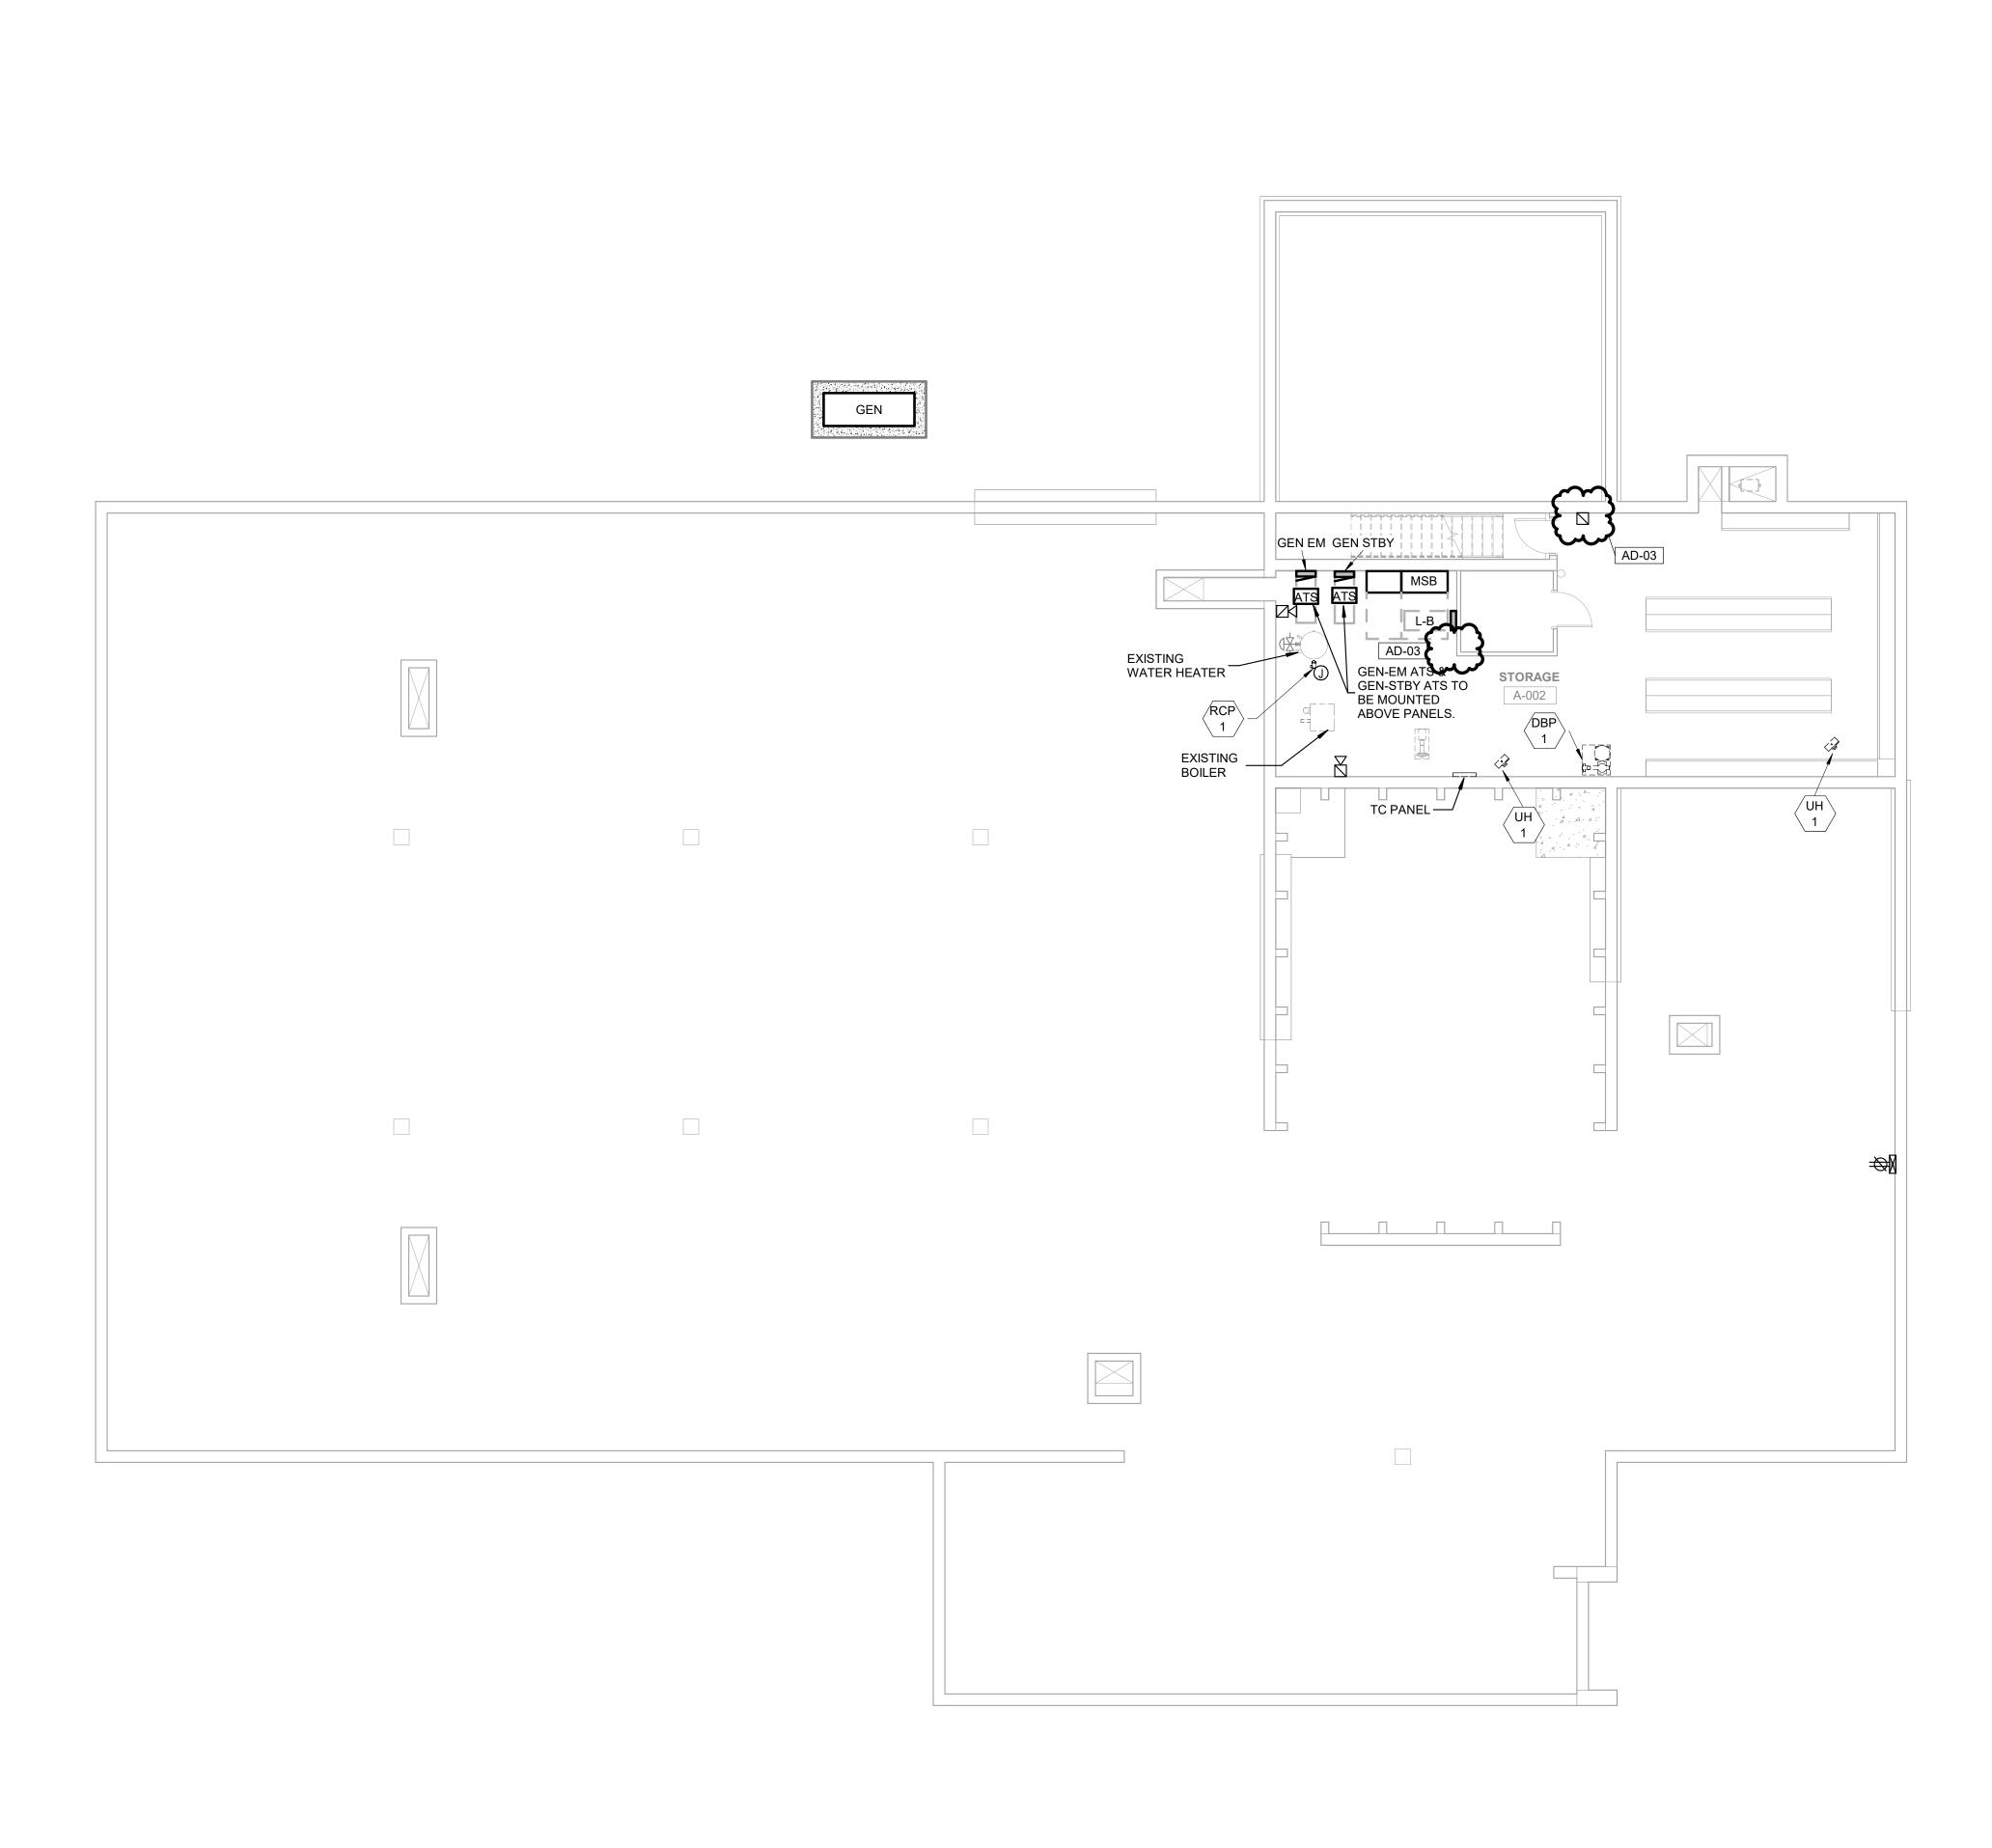

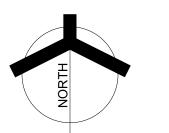

GIBRALTAR
DESIGN
ARCHITECTURE • ENGINEERING • INTERIOR DESIGN

ENGINEERI (219) 924-84 www.milliesengineeri

RO IECT:

EARLY
LEARNING
CENTER
ADDITION AND
RENOVATION

Tippecanoe School Corporation

111 Walter Scholer Dr, Lafayette, IN 47909

GIBRALTAR DESIGN

9102 N. Meridian St., Ste. 300 Indianapolis, IN 46260 Homepage: www.GibraltarDesign.com Email: info@GibraltarDesign.com Phone 317.580.5777 Fax 317.580.5778

PROJECT
25-147
DATE
07/09/2025
COORDINATED BY
SM
DRAWN BY

CHECKED BY

STATE OF AVDIANA ENGINEERING AND AVDIANA ENGINEERING AVDIANA ENGIN

COPYRIGHT NOTICE:

THE CONCEPTS, DESIGNS, PLANS, DETAILS, ETC, SHOWN ON THIS DOCUMENT ARE THE PROPERTY OF GIBRALTAR DESIGN AND WERE CREATED FOR USE ON THIS SPECIFIC PROJECT. NONE OF THIS INFORMATION SHALL BE USED BY ANY PERSON OR FIRM FOR ANY PURPOSE WITHOUT THE EXPRESS WRITTEN CONSENT OF GIBRALTAR DESIGN. THE OWNER MAY RETAIN COPIES FOR INFORMATION AND REFERENCE IN CONNECTION ONLY WITH THIS PROJECT.

REVISIONS

 MARK
 DATE
 ISSUED FOR

 AD-01
 07/23/25
 ADDENDUM NO. 1

 AD-02
 07/30/25
 ADDENDUM NO. 2


 AD-03
 08/01/25
 ADDENDUM NO. 3

DRAWING
ELECTRICAL POWER
BASEMENT FLOOR PLAN

PROJECT
EARLY LEARNING CENTER
ADDITION AND RENOVATION

© GIBRALTAR DESIGN

EP102

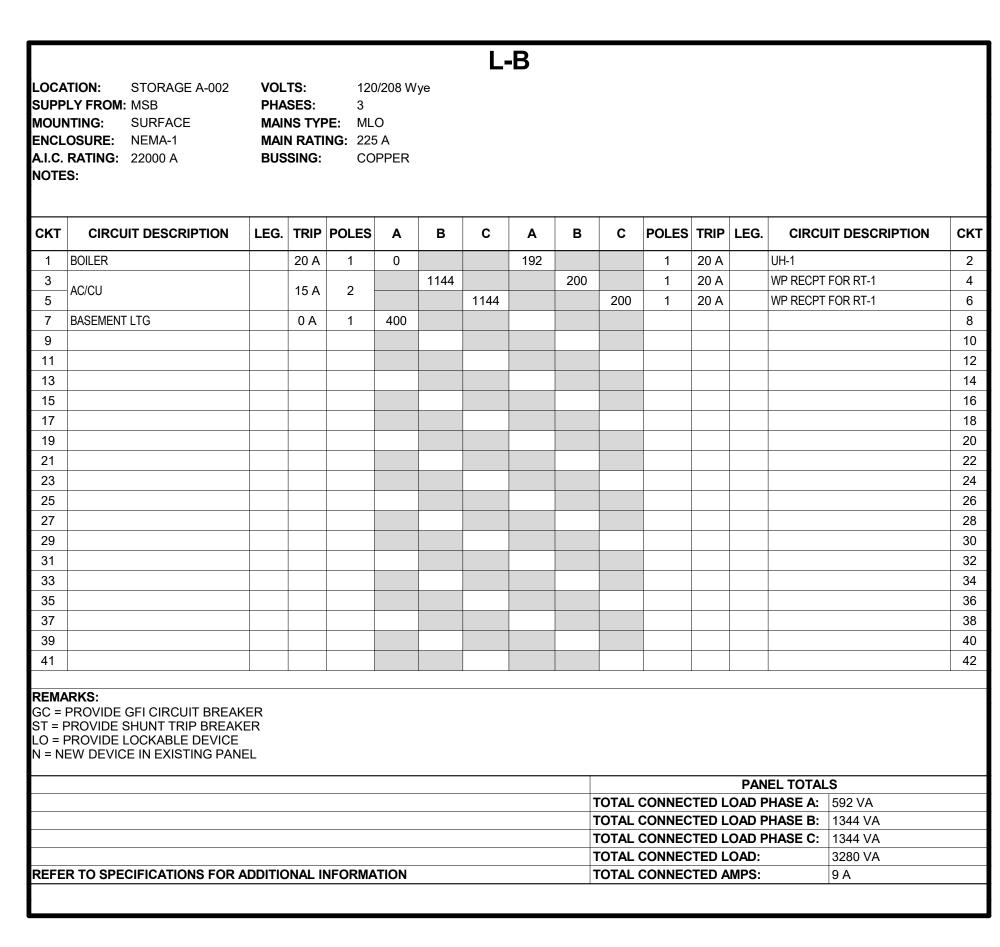


СКТ	CIRCUIT DESCRIPTION	LEG.	TRIP	POLES	Α	В	С	Α	В	С	POLES	TRIP	LEG.	CIRCUIT DESCRIPTION	СКТ
1	CLASSRM A-136 RECPT		20 A	1	1600			1000			1	20 A		CLASSRM A-141 RECPT	2
3	CLASSRM A-136 TEACHER		20 A	1		1000			900		1	20 A		CLASSRM A-141 TEACHER	4
5	SUPPORT A-138 RECPT		20 A	1			400			400	1	20 A		SUPPORT A-140 RECEPT	6
7	SUPPORT A-138 TV		20 A	1	400			400			1	20 A		SUPPORT A-140 TV	8
9	VESTIBULE A-139 DOOR		20 A	1		2400			200		1	20 A		TOILET A-142 RECPT	10
11	TOILET A-132 RECPT		20 A	1			200			900	1	20 A		CLASSROM A-144 TEACHER	12
13	CLASSRM A-133 TEACHER		20 A	1	900			1200			1	20 A		CLASSROM A-144 RECPT	14
15	CLASSRM A-133 RECPT		20 A	1		1600			400		1	20 A		SUPPORT A-143 TV	16
17	SUPPORT A-135 TV		20 A	1			400			400	1	20 A		SUPPORT A-143 RECEPT	18
19	SUPPORT A-135 RECPT		20 A	1	400			200		100	1	20 A		TOILET A-143 RECEPT	20
21	TOILET A-134 RECPT		20 A	1		200			1200		1	20 A		CLASSRM A-146 RECPT	22
23	CLASSRM A-131 RECPT		20 A	1			1200			900	1	20 A		CLASSROM A-146 TEACHER	24
25	CLASSRM A-131		20 A	1	900			200			1	20 A		TOILET A-147 RECEPT	26
27	TOILET A-143 RECEPT		20 A	1		200			200		1	20 A		A-147 ADJSUTABLE BED	28
29	A-147 ADJSUTABLE BED		20 A	1			200		200	200	1	20 A	GC	EWC	30
31	MDF A-128 / CUST. A-127 RECPT		20 A	1	600		200	200		200	1	20 A	GC	EWC	32
33	CORRIDOR A-130 RECPT		20 A	1		1000		200	1200		1	20 A		VESTIBULE A-125 DOOR	34
35	CH-1		20 A	1		1000	240		1200	1200	1	20 A		FLEX 1-124 RECPT	36
37	LIGHTING		20 A	1	1275		210	400		1200	1	20 A		FLEX 1-124 TV	38
39	LIGHTING		20 A	1	1270	405	~	~~~	1315	~~~		20 A	~~	CIGHTING	48
		~~	2016	~~~	~~	~~	108		1010	0	1	20 A		SPARE	42
43	EXIT SIGNS		20 A	1	5			0			1	20 A		SPARE	44
45	SPARE		20 A	1		0			0		1	20 A		SPARE	46
47	SPARE		20 A	1			0			0	1	20 A		SPARE	48
49	SPARE		2 A	1	0			0			1	2 A		SPARE	50
51	SPARE		20 A			0			0		1	20 A		SPARE	52
	SPACELLAND	-4	44	- A 1 A A		-4 -4	A&- A&	سو	سن	سيب	اب	نيت	سيى	SPACE CONTRACTOR OF THE PARTY O	مير الم
55	SPACE		-	1			3505				1			SPACE	56
				1							1				
				-							1				
GC = ST = F LO = F	SPACE SPACE ARKS: PROVIDE GFI CIRCUIT BREAKE PROVIDE SHUNT TRIP BREAKE PROVIDE LOCKABLE DEVICE EW DEVICE IN EXISTING PANE	 ER ER		1							1 1			SPACE SPACE	58 60

		N RATI SSING:	3 PE: ML NG: 200 CC		ye									
RCUIT DESCRIPTION	LEG.	TRIP	POLES	Α	В	С	A	В	С	POLES	TRIP	LEG.	CIRCUIT DESCRIPTION	СК
BULE A-101 DOOR		20 A	1	2400			200			1	20 A		A-110 RESTROOM RECPT	2
RETARY A-102 RECPT		20 A	1		400			200		1	20 A		A-111 RESTROOM RECPT	4
RETARY A-102 RECPT		20 A	1			1000			200	1	20 A		COMMONS A-109 RECPT	6
TOR A-103 RECPT		20 A	1	600			800			1	20 A		INDOOR PLAY A-117 RECPT	8
TOR A-103 RECPT		20 A	1		900			800		1	20 A		INDOOR PLAY A-117 RECPT	10
ERENCE A-104 RECPT		20 A	1			600			200	1	20 A		OPEN OFFICE A-118 RECEPT	12
ERENCE A-104 TEACHER		20 A	1	400			400			1	20 A		OPEN OFFICE A-118 RECEPT	14
	+		1		800			200		1			OPEN OFFICE A-118 RECEPT	16
					300	1000			400	1			0. 2 0	18
	+			800		1.000	600		100					20
				000	600		000	200						22
			-		000	1300		200	1300	-				24
				500		1300	400		1300					20
			-	300	1000		400	675						28
			-		1000	900		0/3	405					30
ROOM A-113 FRIDGE			-	400		800	1110		405					_
			-	420	400		1140	000		-				32
			-		420	400		882	4.5	-				34
				400		420	4.5		45					36
			•	420			15							38
			-		0	_		168		1				40
			-			0			0	1				42
			-	0			0			1				44
		20 A	1		0			0		1	20 A			46
<u>:</u>		20 A	1			0			0	1	20 A		SPARE	48
<u> </u>		20 A	1	0			0			1	20 A		SPARE	50
<u> </u>			1					0		1	20 A		SPARE	52
<u>:</u>			1							1			SPACE	54
:			1							1			SPACE	56
<u> </u>			1							1			SPACE	58
-			1							1			SPACE	60
	RETARY A-102 RECPT RETARY A-102 RECPT CTOR A-103 RECPT ETOR A-103 RECPT ERENCE A-104 RECPT ERENCE A-104 TEACHER HONS A-109 RECPT GROOM A-108 RECPT ERENCE A-113 RECPT ESMENT A-114 RECPT ESMENT A-115 FRIDGE RIOR LTG E	RETARY A-102 RECPT RETARY A-102 RECPT ETOR A-103 RECPT ETOR A-103 RECPT ERENCE A-104 RECPT ERENCE A-104 TEACHER HONS A-109 RECPT ERENCE A-113 RECPT ERENCE A-113 RECPT ESMENT A-114 TEACHER KROOM A-115 FRIDGE RIOR LTG E E	RETARY A-102 RECPT RETARY A-102 RECPT RETARY A-103 RECPT RETOR A-103 RECPT RENCE A-104 RECPT RERENCE A-104 RECPT RENCE A-104 TEACHER RENCE A-109 RECPT RECOM A-108 RECPT RECOM A-108 RECPT RECOM A-108 RECPT RECOM A-108 RECPT RECOM A-113 RECPT RECOM A-114 RECPT RECOM A-115 RECPT RECOM A-115 FRIDGE RECOM A-115 FRIDGE RECOM A-115 A RECOM A-108 RECPT RECOM A-108	RETARY A-102 RECPT RETARY A-102 RECPT RETARY A-102 RECPT RETARY A-103 RECPT RETOR A-103 RECPT RETOR A-103 RECPT RETOR A-104 RECPT RETOR A-104 RECPT RETOR A-104 RECPT RETOR A-104 TEACHER RETOR A-109 RECPT RETOR	RETARY A-102 RECPT RETARY A-102 RECPT RETARY A-102 RECPT RETARY A-102 RECPT RETOR A-103 RECPT RETOR A-103 RECPT RETOR A-104 RECPT RERENCE A-104 RECPT RERENCE A-104 TEACHER RETOR A-109 RECPT RERENCE A-108 RECPT RECOM A-108 RECPT RECOM A-108 RECPT RESMENT A-114 RECPT RESMENT A-114 TEACHER RECOM A-115 RECPT RECOM A-115 FRIDGE RECOM A-115 FRIDGE RECOM A-115 RECPT RECOM A-108 RECPT RETARY A-108 RECPT RETARY A-108 RECPT RETARY A-108 RECPT RETARY A-109 RECPT RETARY A-102	RETARY A-102 RECPT RETARY A-102 RECPT RETARY A-102 RECPT RETARY A-103 RECPT RETARY A-104 RECPT RETARY A-104 RECPT RETARY A-105	RETARY A-102 RECPT 20 A 1	RETARY A-102 RECPT RETARY A-102 RECPT RETARY A-102 RECPT RETARY A-103	RETARY A-102 RECPT 20 A 1

		MS	SB						
N: STORAGE A-002	VOLTS:		120/208	Wye					
FROM:	PHASES:		3	•					
NG: SURFACE	MAINS TY	PE:	MLO						
URE: NEMA-1	MAIN RAT	ING:	600 A						
NG : 65000 A	BUSSING	:	COPPE	R					
	LO	AD	OVE	ERCURR	ENT				
CIRCUIT DESCRIPTION	Load	AMPS	RATING	POLES	ADJ	WIRE SIZE	CONDUIT SIZE	LENGTH	REMARI
-B	3280 VA	9 A	0 A	3				27' - 1	
-1	29620 VA	82 A	0 A	3				44' - 10	
-2	23996 VA	67 A	0 A	3				42' - 7	
RT-1	71333 VA	343 A	250 A	2				158' - 0	
RT-2	35299 VA	170 A	150 A	2				96' - 1	
GEN EM	2014 VA	6 A	0 A	3				17' - 5	
GEN STBY	1645 VA	5 A	0 A	3				14' - 1	
			+						
TOTAL CONNECTED LO	ΔD : 167186	464 A							
TOTAL LOAD PHASE			+						
TOTAL LOAD PHASE			+						
	C : 71135 VA		-						
	FROM: IG: SURFACE JRE: NEMA-1 NG: 65000 A CIRCUIT DESCRIPTION -B -1 -2 -2 -3 -1 -2 -3 -3 -4 -4 -5 -5 -7 -7 -7 -7 -7 -7 -7 -7 -7 -7 -7 -7 -7	FROM: IG: SURFACE MAINS TY JRE: NEMA-1 MAIN RAT NG: 65000 A BUSSING CIRCUIT DESCRIPTION Load -B 3280 VA -1 29620 VA -2 23996 VA -2 23996 VA -2 35299 VA -35299 VA -35299 VA -3529 VA	N: STORAGE A-002	PHASES: 3 MAINS TYPE: MLO MAIN RATING: 600 A MAIN RATING: COPPE	N: STORAGE A-002	N: STORAGE A-002	N: STORAGE A-002	N: STORAGE A-002	NE: STORAGE A-002

REFER TO SPECIFICATIONS FOR ADDITIONAL INFORMATION

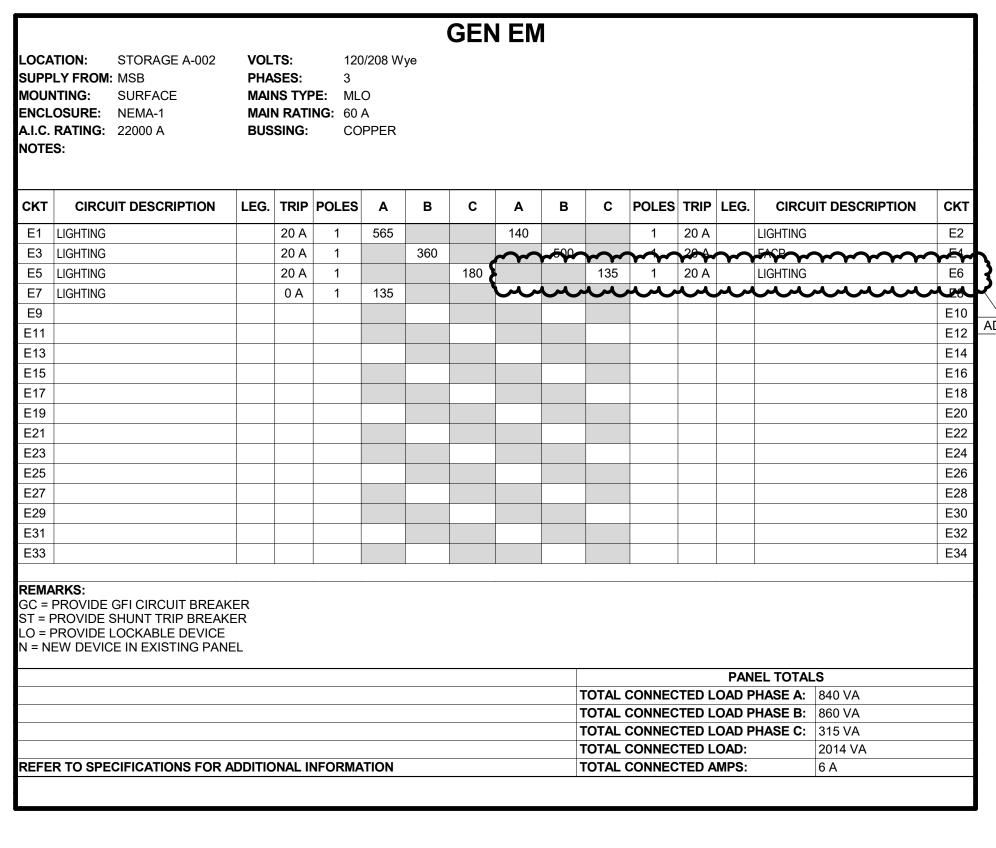

MOUN ENCL	LY FROM: N ITING: S OSURE: N RATING: 2	SURFACE NEMA-1	MAIN	SES: NS TYP	3 PE: ML0 NG: 60 /			EN :	STB	Y							
СКТ	CIRCUIT	T DESCRIPTION	LEG.	TRIP	POLES	Α	В	С	A	В	С	POLES	TRIP	LEG.	CIRCU	IT DESCRIPTION	СК
S1	LIGHTING			20 A	1	190			195			1	20 A		LIGHTING		S2
S3	LIGHTING			20 A	1		195			150		1	20 A		LIGHTING		S4
S5	LIGHTING			20 A	1			135			500	1	20 A		RECIRC PU	MP	Se
S7	TC PANEL			20 A	1	0											S
	LIGHTING			0 A	1		145										S1
	LIGHTING			0 A	1			135									S1
S13																	S1
S15																	S1
S17																	S1
S19																	S2
S21																	S2
S23												-					S2
S25																	S2
S27																	S2
S29												-					S3
S31																	S3
S33																	S34
REMA GC = F ST = P LO = P	PROVIDE G PROVIDE SH PROVIDE LO	FI CIRCUIT BREAKE HUNT TRIP BREAKE DCKABLE DEVICE IN EXISTING PANE	R														
															EL TOTAL		
															HASE A:		
															HASE B:		
											IUIAL						
												CONNEC			TIAGE C.	770 VA 1645 VA	



ENGINEERING
(219) 924-8400
www.milliesengineeringgroup.co

EARLY LEARNING CENTER ADDITION AND RENOVATION

Tippecanoe School Corporation 111 Walter Scholer Dr, Lafayette, IN

GIBRALTAR DESIGN

9102 N. Meridian St., Ste. 300 Indianapolis, IN 46260 Homepage: www.GibraltarDesign.com Email: info@GibraltarDesign.com Phone 317.580.5777 Fax 317.580.5778

PROJECT 25-147 DATE 07/09/2025 COORDINATED BY DRAWN BY CHECKED BY

COPYRIGHT NOTICE: THE CONCEPTS, DESIGNS, PLANS, DETAILS, ETC, SHOWN ON THIS DOCUMENT ARE THE PROPERTY OF GIBRALTAR DESIGN AND WERE CREATED FOR USE ON THIS SPECIFIC PROJECT. NONE OF THIS INFORMATION SHALL BE USED BY ANY PERSON OR FIRM FOR ANY PURPOSE WITHOUT THE EXPRESS WRITTEN CONSENT OF GIBRALTAR DESIGN. THE OWNER MAY RETAIN COPIES FOR INFORMATION AND REFERENCE IN CONNECTION ONLY WITH THIS PROJECT.

REVISIONS

MARK DATE ISSUED FOR AD-01 07/23/25 ADDENDUM NO. 1 AD-02 07/30/25 ADDENDUM NO. 2 AD-03 08/01/25 ADDENDUM NO.3

| ELECTRICAL SCHEDULES

PROJECT EARLY LEARNING CENTER
ADDITION AND RENOVATION

© GIBRALTAR DESIGN

1	MECHANICAL EQUIPMENT CONNECTION SCHEDULE																			
			LC	DAD							FEE	DER		ISCONNE	CT SWITC	Н	STARTER			
															PRO\	/. BY		PROV.	. BY:	
TAG	DESCRIPTION	WATTS	HP	MCA	FLA	MOCP	VOLT	PHASE	PANEL	CKT. NO.	CABLE	CONDUIT	SIZE	FUSE	M.C./P.C.	E.C.	TYPE	M.C./P.C.	E.C.	REMARKS
AC / CU-1	AC / CONDENSING UNIT	2288		11		15	208	1	L-B	3,5								X		
DBP-1	DOMESTIC BOOSTER PUMP				9.1		208	3		<unnamed></unnamed>										
EWC-1					5		120	1												
RCP-1	RECIRCULATION PUMP	0			2.1		120	1												
RT-1	ROOF TOP UNIT	71333		198		250	208	3	MSB	4								Х		
RT-2	ROOF TOP UNIT	35299		120		150	208	2		<unnamed></unnamed>								Х		
TEF-1	TOILET EXHAUST FAN	420		3.5		15	120	1	L-2	31									Х	
TEF-2	TOILET EXHAUST FAN	420		3.5		15	120	1	L-2	33									Х	
TEF-3	TOILET EXHAUST FAN	420		3.5		15	120	1	L-2	35									Х	
TEF-4	TOILET EXHAUST FAN	420		3.5		15	120	1	L-2	37									Х	
UH-1	UNIT HEATER	96			0.8	15	120	1	L-B	2								Х		
UH-1	UNIT HEATER	96			0.8	15	120	1	L-B	2								Х		



DESIGN ARCHITECTURE • ENGINEERING • INTERIOR DESIGN

ENGINEERING (219) 924-8400 PROJECT:

EARLY LEARNING CENTER ADDITION AND RENOVATION

Tippecanoe School Corporation 111 Walter Scholer Dr, Lafayette, IN

GIBRALTAR DESIGN

9102 N. Meridian St., Ste. 300 Indianapolis, IN 46260 Homepage: www.GibraltarDesign.com Email: info@GibraltarDesign.com Phone 317.580.5777 Fax 317.580.5778


PROJECT 25-147 DATE 07/09/2025 COORDINATED B DRAWN BY CHECKED BY


COPYRIGHT NOTICE: THE CONCEPTS, DESIGNS, PLANS, DETAILS, ETC, SHOWN ON THIS DOCUMENT ARE THE PROPERTY OF GIBRALTAR DESIGN
AND WERE CREATED FOR USE ON THIS SPECIFIC PROJECT.
NONE OF THIS INFORMATION SHALL BE USED BY ANY PERSON OR FIRM FOR ANY PURPOSE WITHOUT THE EXPRESS WRITTEN CONSENT OF GIBRALTAR DESIGN. THE OWNER MAY RETAIN COPIES FOR INFORMATION AND REFERENCE IN CONNECTION ONLY WITH THIS PROJECT.


REVISIONS MARK DATE ISSUED FOR AD-01 07/23/25 ADDENDUM NO. 1 AD-02 07/30/25 ADDENDUM NO. 2 AD-03 08/01/25 ADDENDUM NO.3

ELECTRICAL SCHEDULES

PROJECT EARLY LEARNING CENTER ADDITION AND RENOVATION

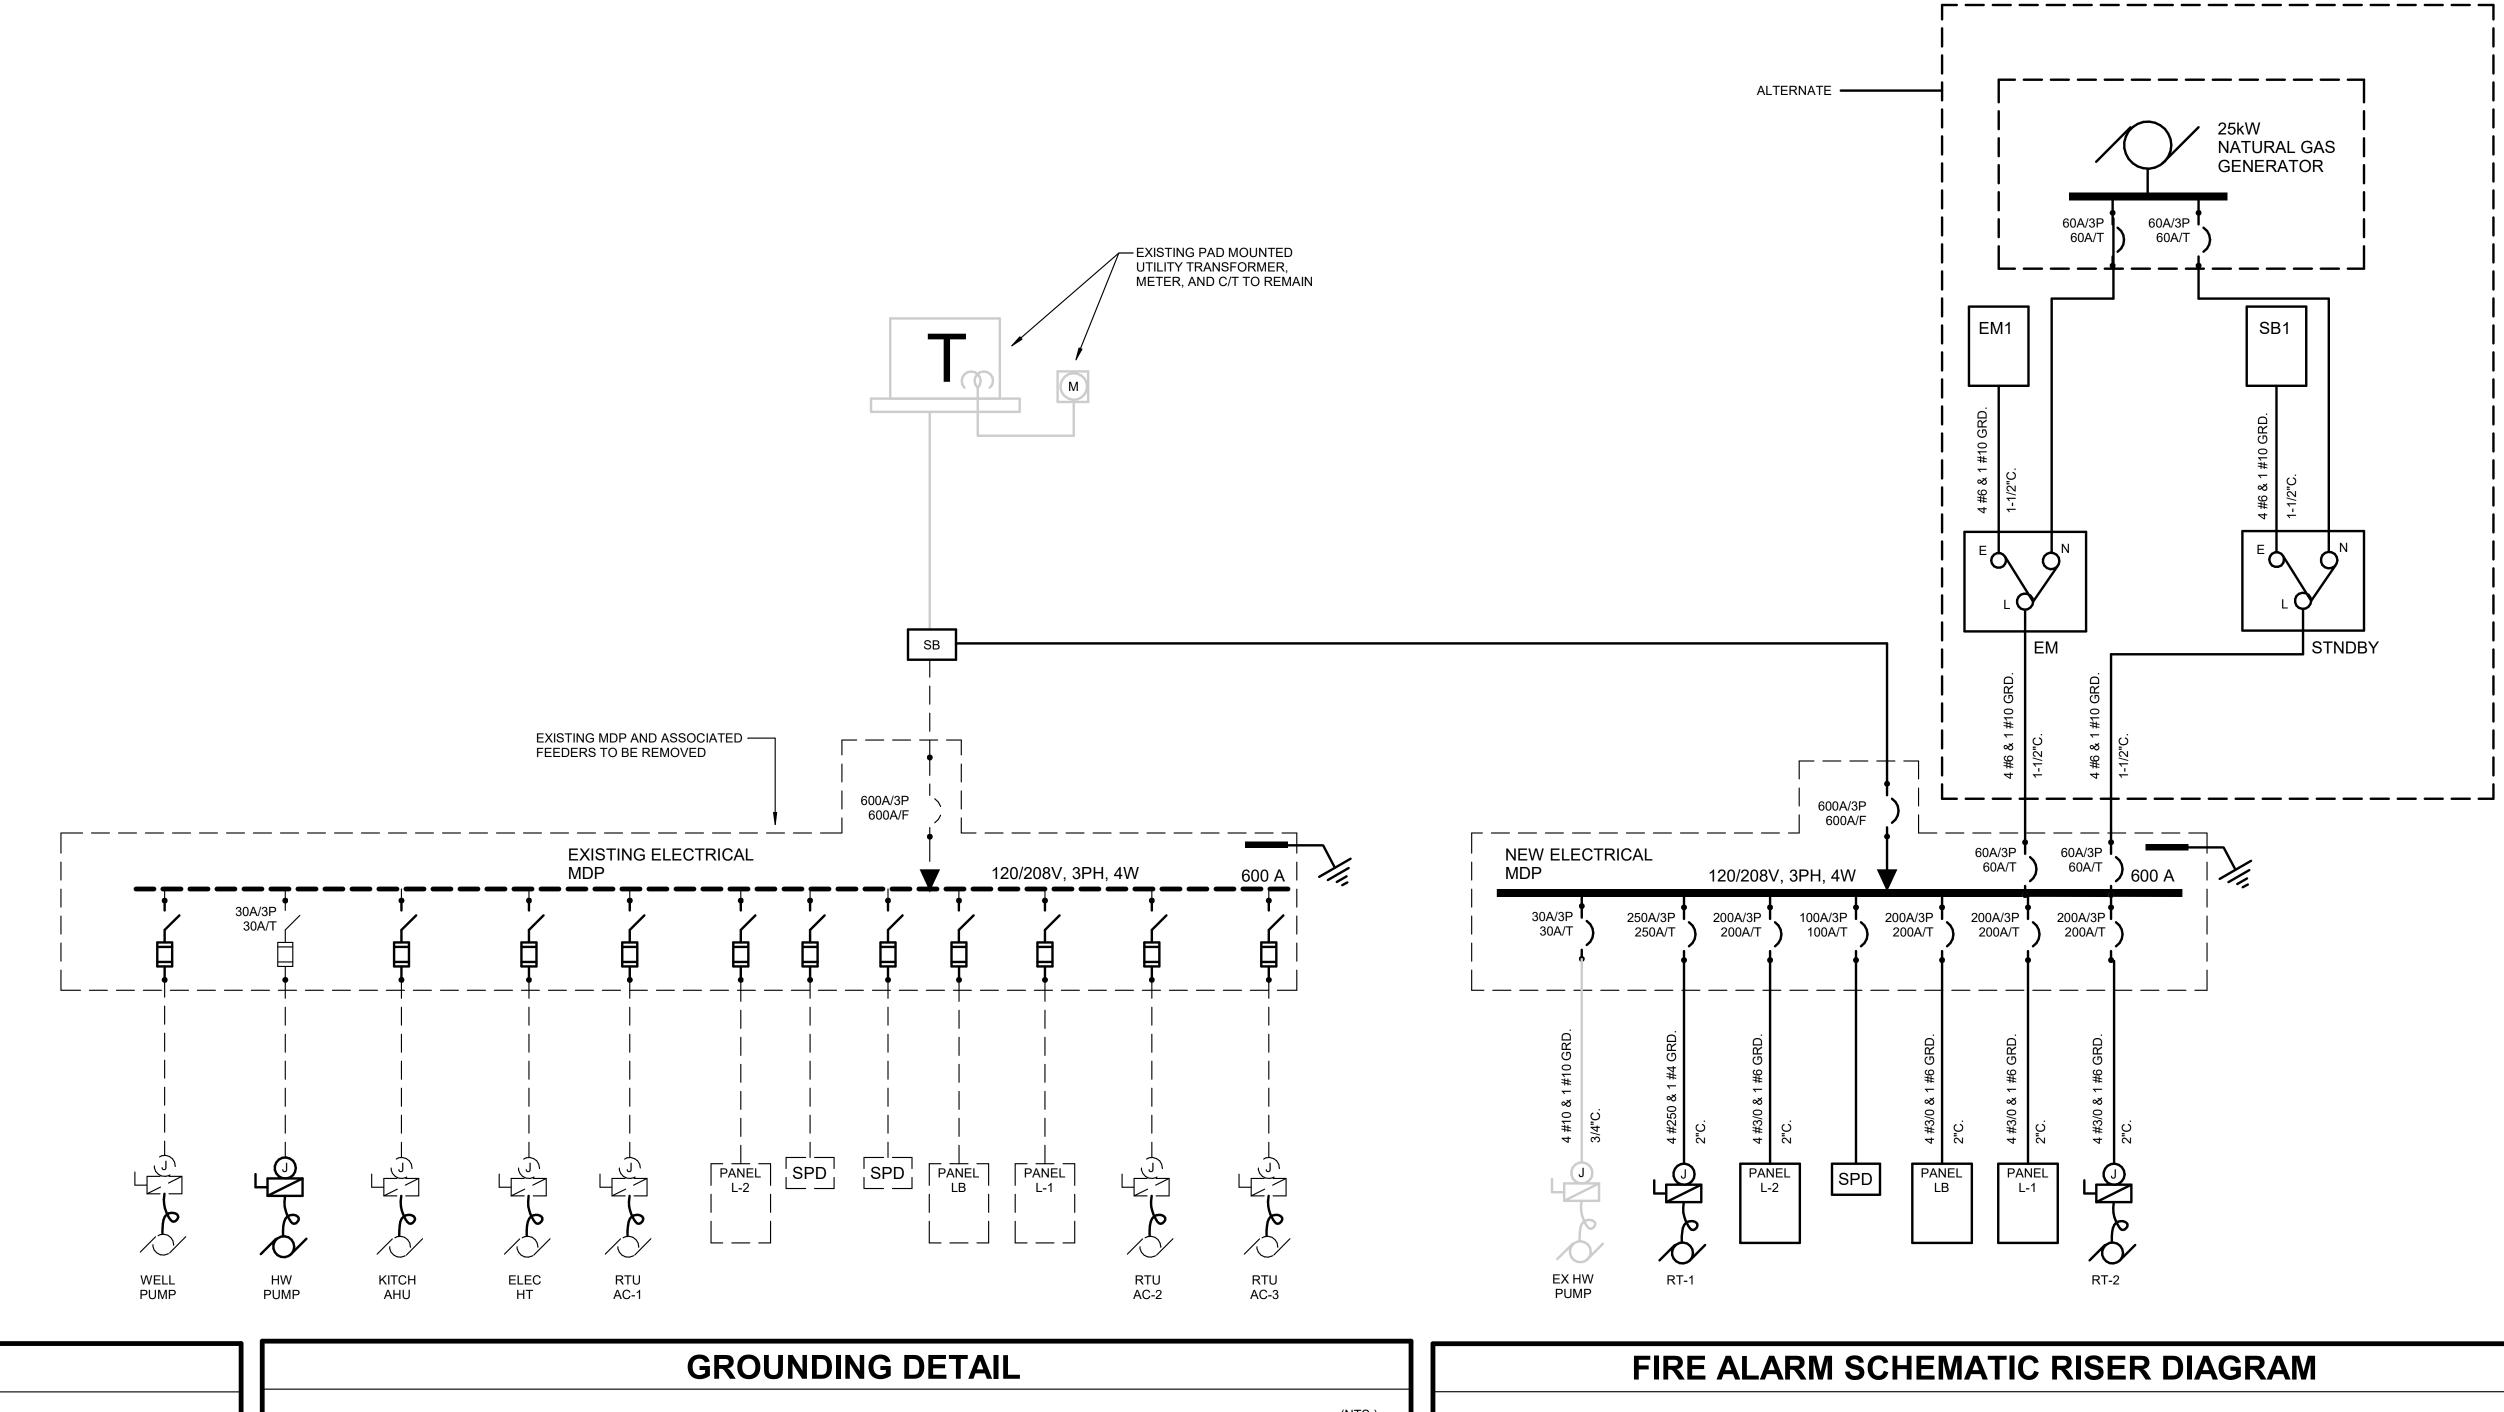

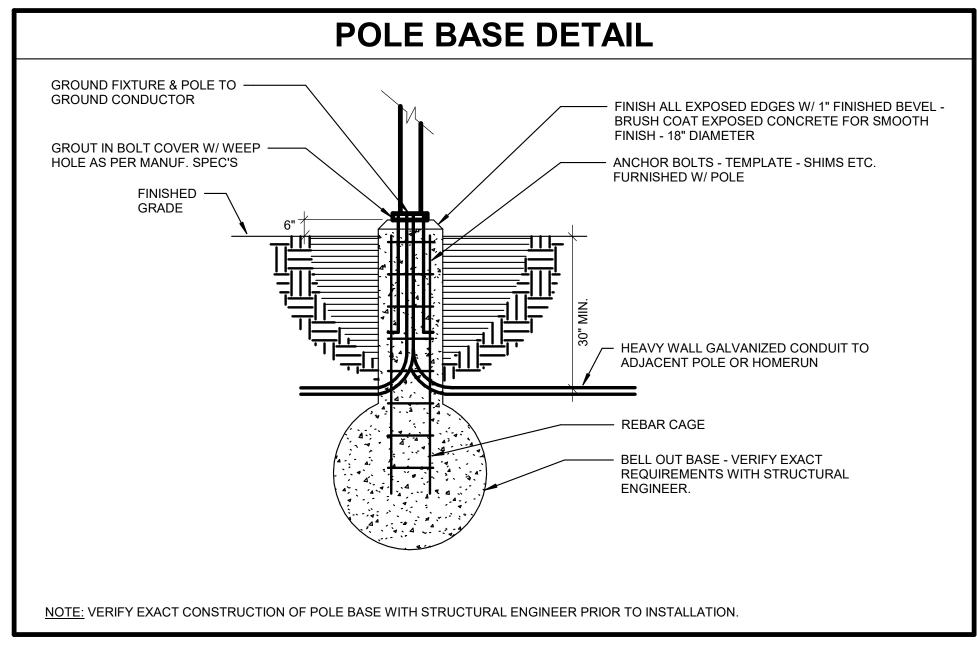

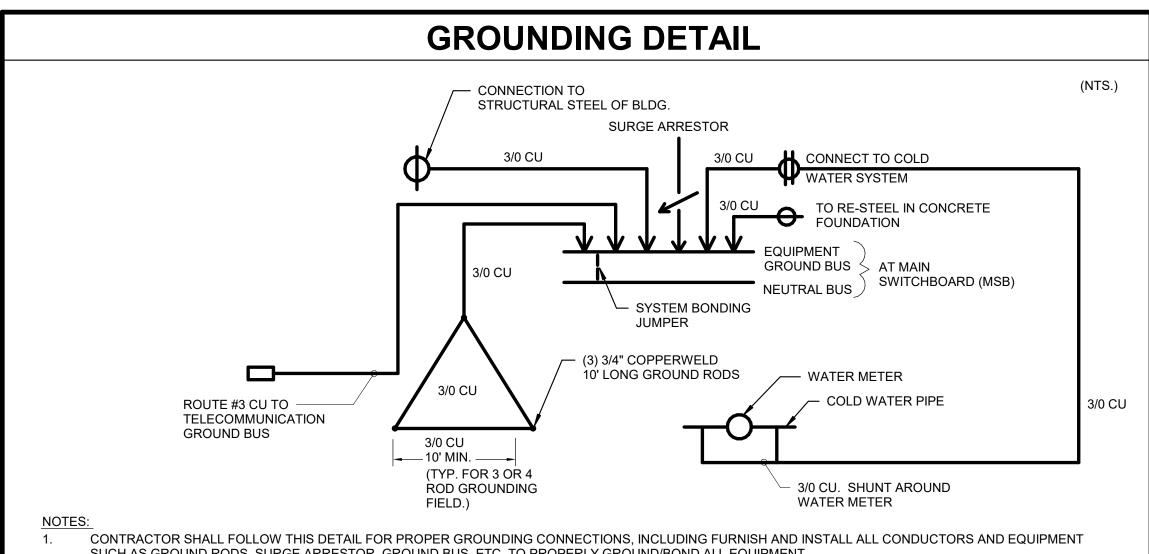



SUCH AS GROUND RODS, SURGE ARRESTOR, GROUND BUS, ETC. TO PROPERLY GROUND/BOND ALL EQUIPMENT. SYSTEM GROUNDING FOR INTERIOR DISTRIBUTION TRANSFORMERS SHALL BE MADE TO A GROUNDING ELECTRODE AS NEAR AS PRACTICAL TO, AND PREFERABLY IN THE SAME AREA AS, THE TRANSFORMER. THE ELECTRODE SHALL BE THE NEAREST OF A METAL WATER PIPE GROUNDING ELECTRODE OR STRUCTURAL METAL GROUNDING ELECTRODE.

- GROUNDING ELECTRODE RESISTANCE SHALL BE 25 OHMS OR LESS. SHOULD THE MEASURED RESISTANCE BE HIGHER THAN 25 OHMS, ADDITIONAL SUPPLEMENTAL ELECTRODES SHALL BE PROVIDED AS REQUIRED TO REACH A RESISTANCE TO EARTH OF 25 OHMS OR LESS.
- IN ADDITION TO THE ABOVE DEPICTED CONNECTIONS, CONTRACTOR SHALL PROVIDE ALL GROUND RODS, GROUND GRIDS, AND OTHER GROUNDING ELECTRODES AS REQUIRED BY THE UTILITY COMPANY AND MAKE CONNECTIONS TO UTILITY EQUIPMENT PER UTILITY COMPANY STANDARDS.

KEY TO ELECTRICAL CIRCUIT WIRING —— PHASE CON DUCTOR(S), SWITCH LEG OR GO-BETWEEN (— NEUTRAL CONDUCTOR(S) GROUND CONDUCTOR(S) #1,3,5 - ALL CONDUCTORS #12 AWG NOTED UNLESS OTHERWISE PANEL DESIGNATION CIRCUIT NO. DESIGNATION NOTES:

- ALL WIRING SHALL BE #12 AWG, UNLESS OTHER WISE NOTED.
- MINIMUM CONDUIT SIZE SH ALL BE 3/4" EXCEPT FOR THREE (3) WIRES OR LESS, OR CONTROL WIRING WITHIN BUILDINGS, WHICH MAY BE 1/2" CONDUIT.
- 1/2" FLEXSTEEL, GREENFIELD OR SEALITE SHALL BE THE MINIMUM SIZE INSTALLED.

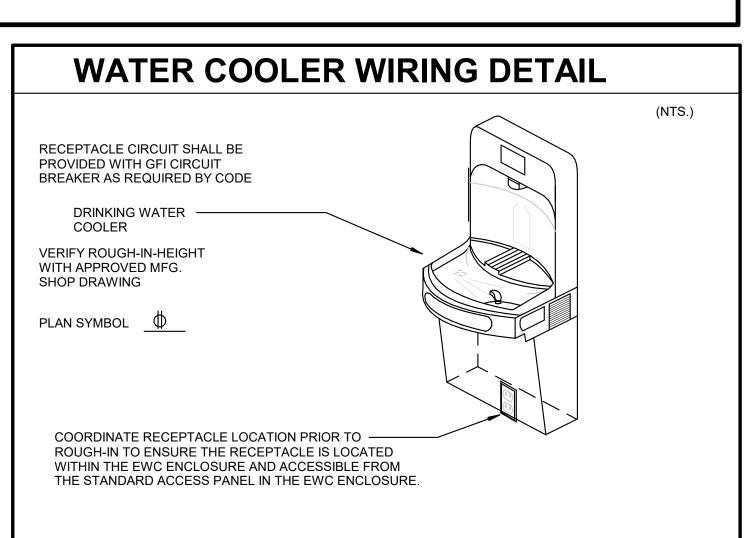

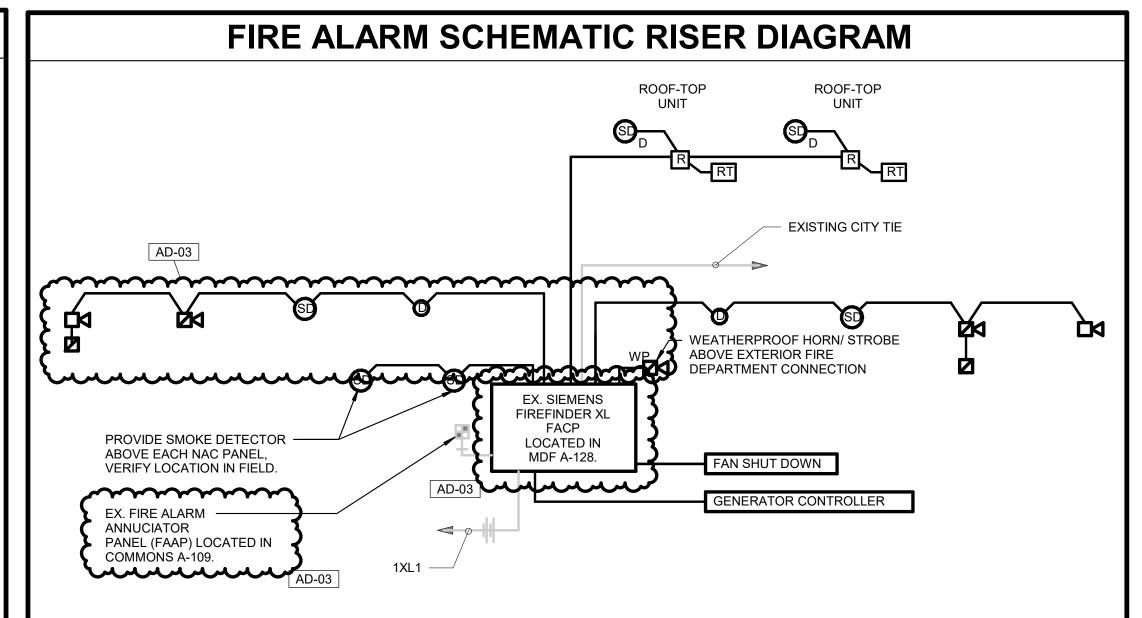

THIS DIAGRAM IS SCHEMATIC ONLY AND DOES NOT SHOW ALL FIRE ALARM DEVICES. AIR HANDLING UNITS. ROOF-TOP UNITS OR FIRE PROTECTION DEVICES - REFER TO ALL PLANS AND SPECIFICATIONS FOR QUANTITIES, LOCATION, ACCEPTABLE MANUFACTURERS, ETC.

ELECTRICAL CONTRACTOR SHALL FURNISH DUCT SMOKE DETECTORS. MECHANICAL CONTRACTOR SHALL INSTALL DUCT SMOKE DETECTOR AND ELECTRICAL CONTRACTOR SHALL MAKE FINAL WIRING CONNECTIONS AS REQUIRED. REFER TO MECHANICAL DRAWINGS FOR EXACT LOCATIONS AND QUANTITIES OF DUCT SMOKE DETECTORS.

ELECTRICAL CONTRACTOR SHALL PROVIDE INTERLOCKING BETWEEN DUCT SMOKE DETECTORS, FIRE ALARM CONTROL PANEL, AIR HANDLING UNITS, ROOF-TOP UNITS, ANSUL SYSTEM AND FAN SHUT DOWN RELAYS SO THAT UPON ACTIVATION OF FIRE ALARM SYSTEM, ALL AIR HANDLING EQUIPMENT AND SMOKE/FIRE DAMPER SHALL SHUT DOWN. ALL AIR HANDLING EQUIPMENT SHALL START AUTOMATICALLY (AND SEQUENTIALLY) UPON RESETTING OF THE FIRE ALARM SYSTEM.

ELECTRICAL CONTRACTOR SHALL CONNECT SMOKE/FIRE DAMPERS THROUGHOUT FACILITY TO CLOSE DAMPERS UPON ACTIVATION/ALARM OF SMOKE DUCT DETECTOR MOUNTED IN DUCT AHEAD OF RESPECTIVE DAMPER OR LOCAL SMOKE DETECTORS, COMPLETE AS REQUIRED. VERIFY LOCATION AND QUANTITIES ON MECHANICAL AND ARCHITECTURAL PLANS AND IN FIELD. INTERLOCK SMOKE DUCT DETECTORS AND DAMPERS WITH FIRE ALARM CONTROL PANEL, COMPLETE AS REQUIRED.

- PROVIDE ADDITIONAL PARTS, ACCESSORIES, CARDS, ETC. AS REQUIRED TO COMPLETE THE WORK. FIRE ALARM DEVICES SHALL BE CONNECTED TO THE FIRE ALARM POWER SUPPLY AND BATTERIES OF THE SYSTEM AND SHALL NOT BE CONNECTED TO NORMAL POWER.
- PROVIDE ALL RELAYS AND DEVICES AS REQUIRED TO MONITOR GENERATOR STATUS INCLUDING GENERATOR RUNNING AND GENERATOR TROUBLE.

ELECTRICAL DETAILS & DIAGRAMS

GIBRALTAR

DESIGN

ARCHITECTURE • ENGINEERING • INTERIOR DESIGN

EARLY

LEARNING

ADDITION AND

Tippecanoe School Corporation

111 Walter Scholer Dr, Lafayette, IN

GIBRALTAR DESIGN

9102 N. Meridian St., Ste. 300

Homepage: www.GibraltarDesign.com

Email: info@GibraltarDesign.com Phone 317.580.5777 Fax 317.580.5778

THE CONCEPTS, DESIGNS, PLANS, DETAILS, ETC, SHOWN ON

THIS DOCUMENT ARE THE PROPERTY OF GIBRALTAR DESIGN AND WERE CREATED FOR USE ON THIS SPECIFIC PROJECT. NONE OF THIS INFORMATION SHALL BE USED BY ANY

PERSON OR FIRM FOR ANY PURPOSE WITHOUT THE EXPRESS WRITTEN CONSENT OF GIBRALTAR DESIGN. THE OWNER MAY

RETAIN COPIES FOR INFORMATION AND REFERENCE IN CONNECTION ONLY WITH THIS PROJECT.

MARK DATE ISSUED FOR

AD-01 07/23/25 ADDENDUM NO. 1

AD-02 07/30/25 ADDENDUM NO. 2

AD-03 08/01/25 ADDENDUM NO.3

Indianapolis, IN 46260

25-147

07/09/2025

DRAWN BY

CHECKED BY

REVISIONS

COPYRIGHT NOTICE:

COORDINATED B

DATE


RENOVATION


CENTER


ENGINEERING (219) 924-8400

PROJECT EARLY LEARNING CENTER ADDITION AND RENOVATION

© GIBRALTAR DESIGN

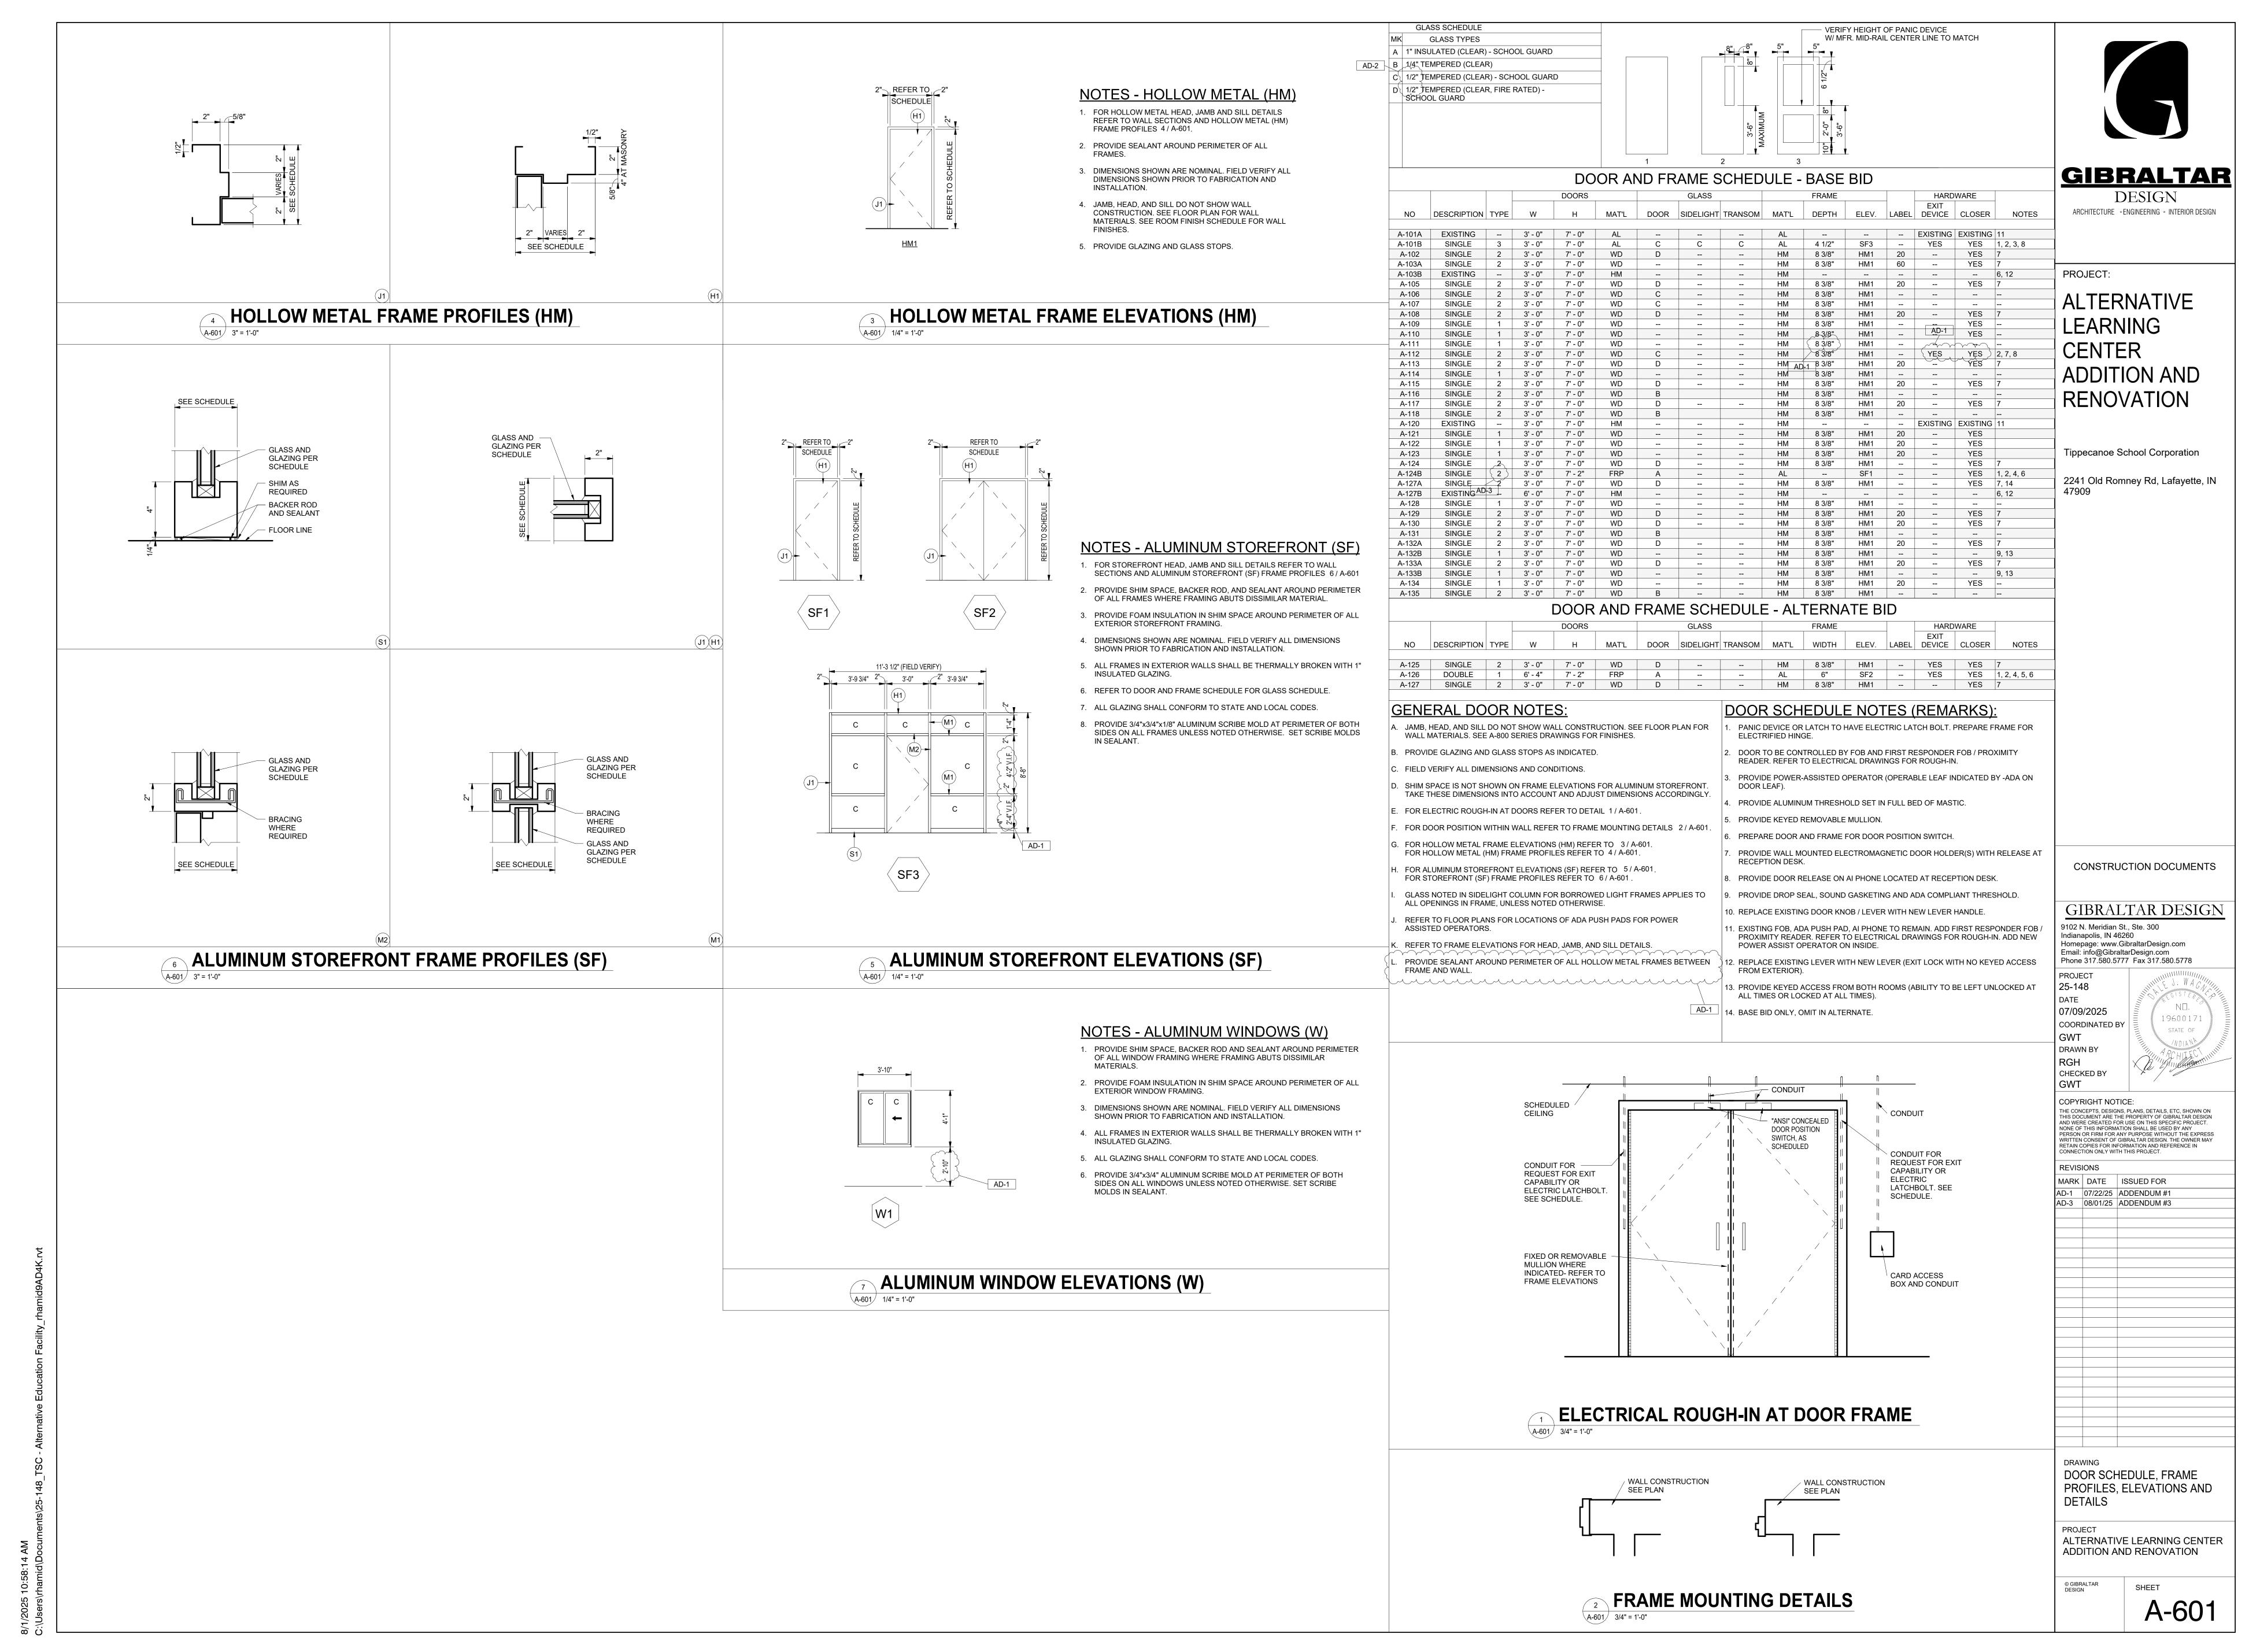

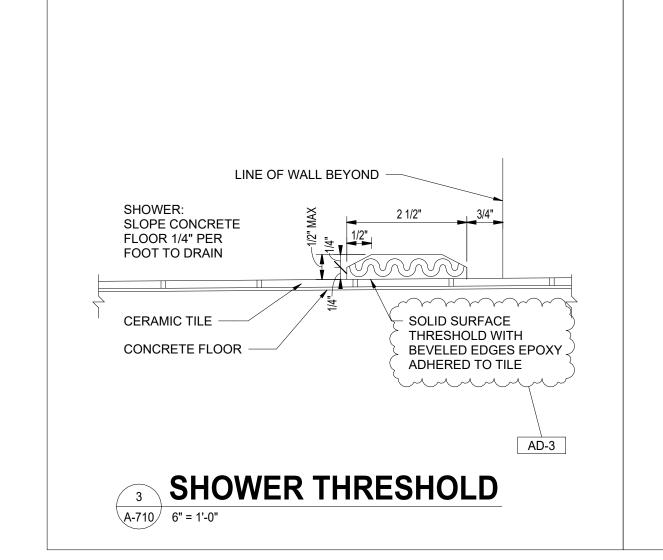

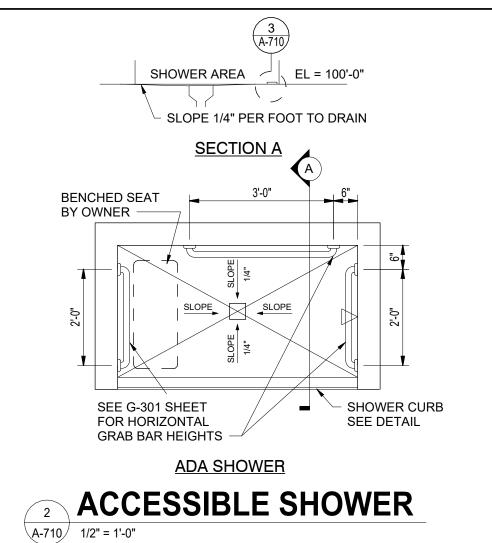

GENERAL RESTROOM NOTES:

- A. FOR GENERAL PROJECT NOTES, MATERIAL INDICATIONS LEGEND, SYMBOL LEGEND, ABBREVIATION, ETC., REFER TO SHEET G-301.
- B. DEPTH OF ALL TOILET ENCLOSURES SHALL BE A MINIMUM OF 5'-0" CLEAR INSIDE DIMENSION UNLESS NOTED OTHERWISE.
- C. REFER TO PLUMBING DRAWINGS FOR FIXTURE TYPES.
- D. REFER TO PLUMBING DRAWINGS FOR FLOOR DRAIN LOCATIONS.
- E. COORDINATE HEIGHT OF GRAB BAR WITH TANK ON FLUSH VALVE OF WALL MOUNTED WATER CLOSET.
- F. INSTALL LAVATORIES AND URINALS AT 2'-6" ON CENTER MINIMUM UNLESS NOTED OTHERWISE.
- G. REFERENCE FINISH PLANS FOR FINISH INFORMATION.

H. FOR MOUNTING HEIGHTS REFER TO SHEET G-301

1 ACCESSIBLE FACILITIES. 1

PLAN NOTES:

- (2) ACCESSIBLE FIXTURE (LAVATORY/URINAL). SEE PLUMBING DRAWINGS.
- (3) TOILET PAPER HOLDER. (CFCI)
- (4) SOAP DISPENSER. (OFCI) AUTOMATIC ELECTRIC HAND DRYER. REFER TO ELECTRICAL DRAWINGS FOR POWER CONNECTION.
- 6 TOILET PARTITION.
- 7) 1'-4", W x, 2'-6" H MIRROR _______ AD-1
- (8) NOT USED
- 9 SHOWER ROD AND CURTAIN
- (10) FEMININE NAPKIN DISPOSAL.
- (11) PAPER TOWEL DISPENSER. (OFCI) (12) FLOOR DRAIN. REFER TO PLUMBING DRAWINGS.
- (13) NOT USED.
- 14) ACCESSIBLE SHOWER. $\frac{2}{A-710}$
- (15) 24"x24" ACCESS PANEL WITH TOP AT 5'-4" ABOVE FLOOR
- (16) SHOWER THRESHOLD. —
- (17) INSTALL WALL SPLASH GUARD BELOW ELECTRIC HAND DRYER. MOUNT TOP 3" BELOW BOTTOM OF HAND DRYER.




DESIGN ARCHITECTURE → ENGINEERING → INTERIOR DESIGN


PROJECT:

ALTERNATIVE LEARNING CENTER **ADDITION AND** RENOVATION


Tippecanoe School Corporation

2241 Old Romney Rd, Lafayette, IN

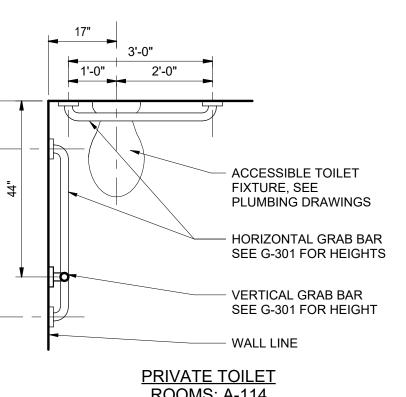

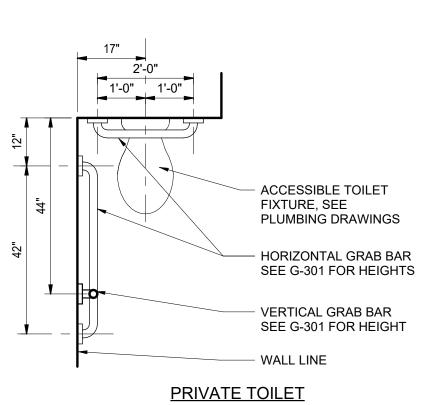

ROOMS: A-109, A-110

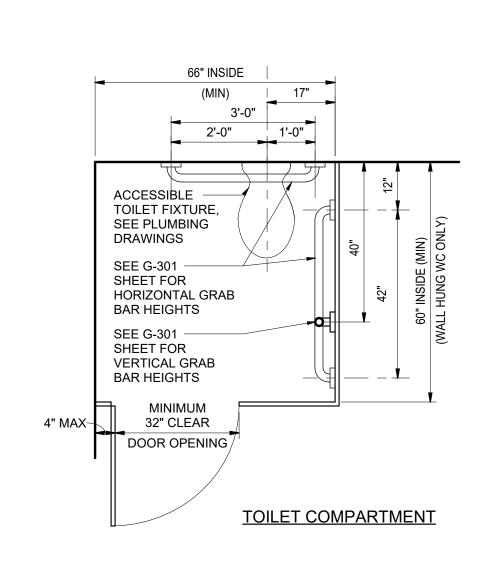





THE CONCEPTS, DESIGNS, PLANS, DETAILS, ETC, SHOWN ON THIS DOCUMENT ARE THE PROPERTY OF GIBRALTAR DESIGN AND WERE CREATED FOR USE ON THIS SPECIFIC PROJECT. NONE OF THIS INFORMATION SHALL BE USED BY ANY PERSON OR FIRM FOR ANY PURPOSE WITHOUT THE EXPRESS WRITTEN CONSENT OF GIBRALTAR DESIGN. THE OWNER MAY RETAIN COPIES FOR INFORMATION AND REFERENCE IN CONNECTION ONLY WITH THIS PROJECT. REVISIONS

CONSTRUCTION DOCUMENTS

19600171


MARK DATE ISSUED FOR AD-1 07/22/25 ADDENDUM #1 AD-3 08/01/25 ADDENDUM #3

ENLARGED TOILET ROOM EQUIPMENT PLANS


PROJECT ALTERNATIVE LEARNING CENTER
ADDITION AND RENOVATION

© GIBRALTAR DESIGN

A-710

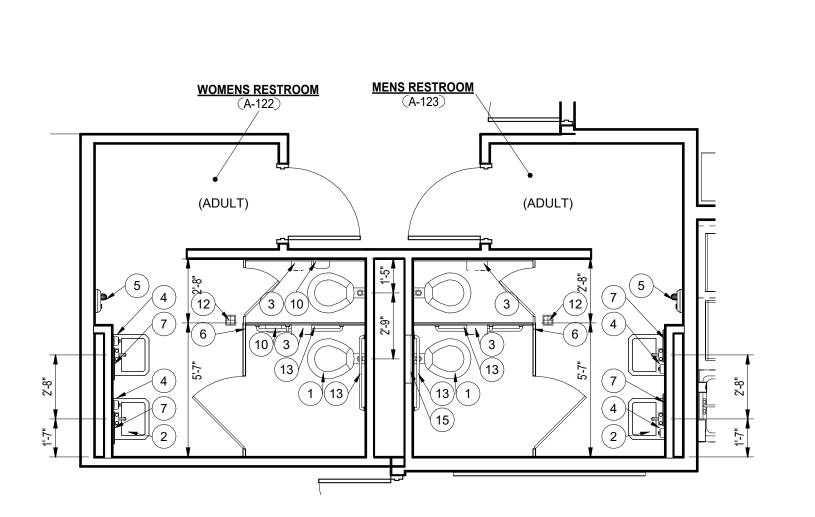



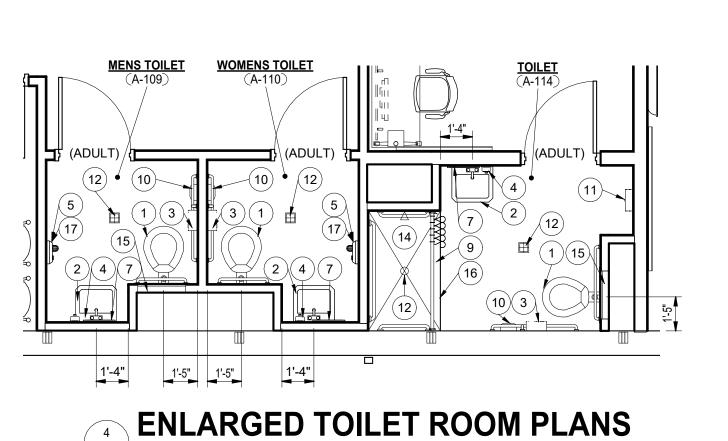



EXISTING MECHANICAL EQUIPMENT TO BE DEMOLISHED. REMOVE EXISTING WIRING BACK TO EXISTING BRANCH PANEL.

DUPLEX RECEPTACLES IN ELEMENTARY CLASSROOM TO BE 120V-20A SPECIFICATION GRADE AFCI TAMPER RESISTANT DUPLEX RECEPTACLE - (MOUNTED 18" A.F.F. OR AS NOTED) (HUBBELL #AFR20TR OR EQUAL); UNLESS NOTED OTHERWISE.



GIBRALTAR DESIGN

ENGINEERING (219) 924-8400 www.milliesengineeringgroup.co

ARCHITECTURE • ENGINEERING • INTERIOR DESIGN

PROJECT:


ALTERNATIVE LEARNING CENTER **ADDITION AND** RENOVATION

Tippecanoe School Corporation


2241 Old Romney Rd, Lafayette, IN 47909




ELECTRICAL LIGHTING FIRST FLOOR PLAN - ALTERNATE BID

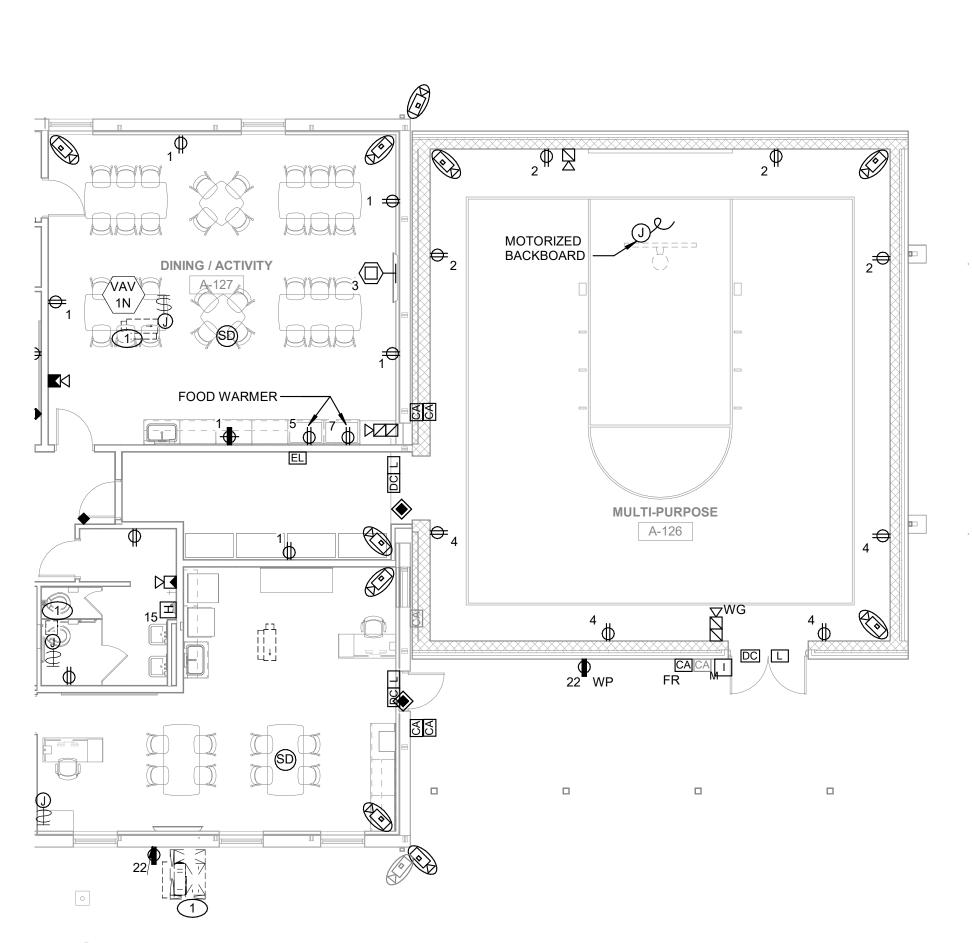

3 ELECTRICAL POWER FIRST FLOOR PLAN - ALTERNATE BID
E-101 1/8" = 1'-0"

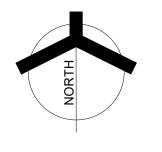

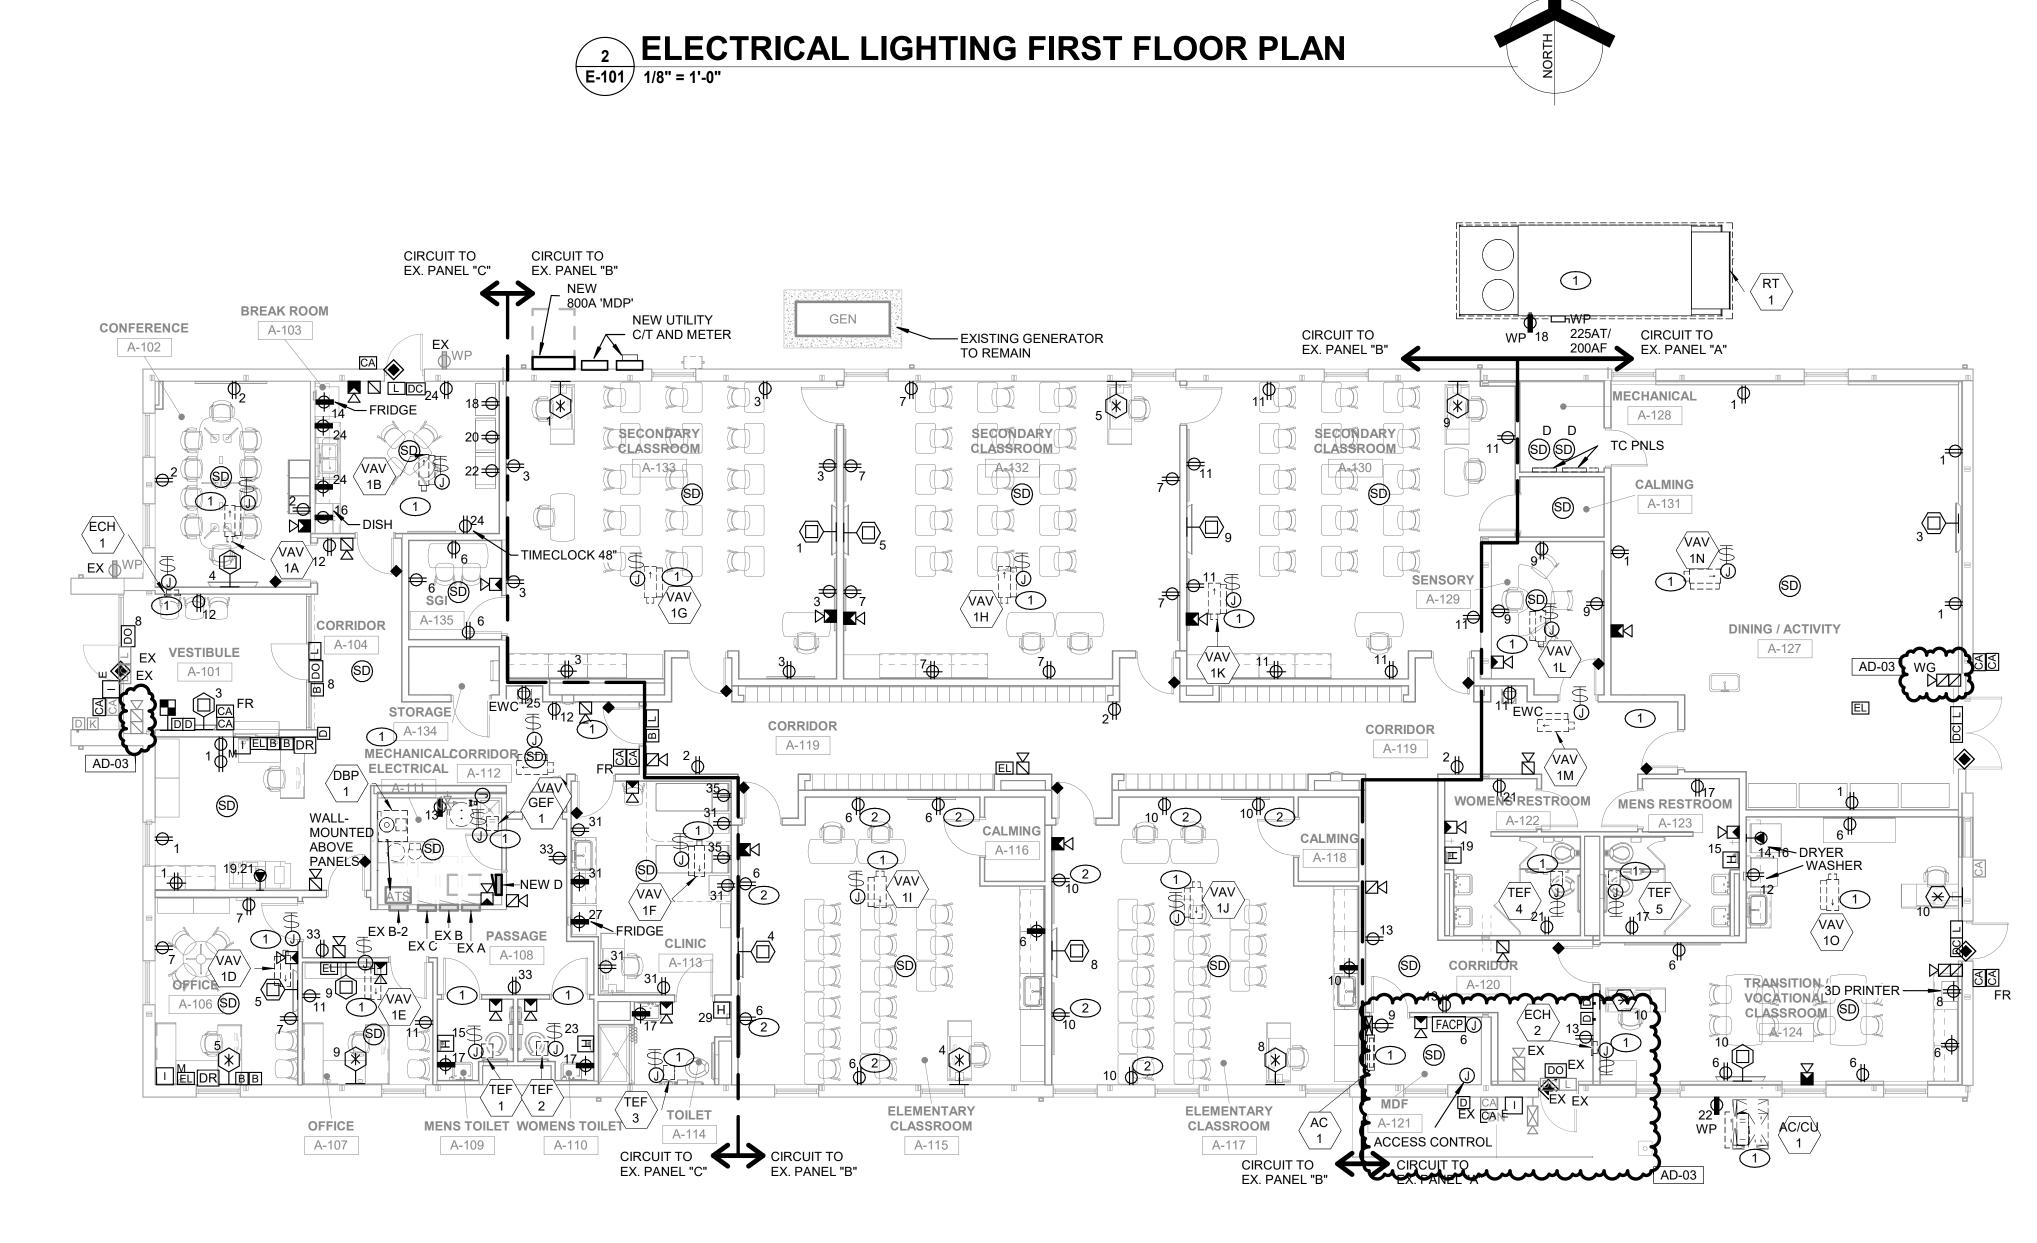

CIRCUIT TO EX. PANEL "C" CIRCUIT TO EX. PANEL "B"

MENS TOILET WOMENS TOILET

EX. PANEL "C"

EX. PANEL "B"

A-109

CONFERENCE BREAK ROOM

A-106

A-107


VESTIBULE 28

A-101

EM 28

NL

1 ELECTRICAL POWER FIRST FLOOR PLAN

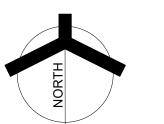

MECHANICAL

CIRCUIT TO

EX. PANEL "B"

CIRCUIT TO EX. PANEL "B"

CIRCUIT TO EX. PANEL "A"

TRANSITION /

VOCATIONAL

CLASSROOM

A-124

GIBRALTAR DESIGN 9102 N. Meridian St., Ste. 300 Indianapolis, IN 46260

Homepage: www.GibraltarDesign.com Email: info@GibraltarDesign.com Phone 317.580.5777 Fax 317.580.5778

23-148 07/09/2025 **COORDINATED BY** DRAWN BY

CHECKED BY COPYRIGHT NOTICE: THE CONCEPTS, DESIGNS, PLANS, DETAILS, ETC, SHOWN ON THIS DOCUMENT ARE THE PROPERTY OF GIBRALTAR DESIGN AND WERE CREATED FOR USE ON THIS SPECIFIC PROJECT. NONE OF THIS INFORMATION SHALL BE USED BY ANY PERSON OR FIRM FOR ANY PURPOSE WITHOUT THE EXPRESS WRITTEN CONSENT OF GIBRALTAR DESIGN. THE OWNER MAY RETAIN COPIES FOR INFORMATION AND REFERENCE IN CONNECTION ONLY WITH THIS PROJECT.

REVISIONS MARK DATE ISSUED FOR AD-01 07/23/25 ADDENDUM NO. AD-02 07/30/25 ADDENDUM NO. 2

AD-03 08/01/25 ADDENDUM NO. 3

ELECTRICAL FIRST FLOOR **PLANS**

PROJECT

ALTERNATIVE LEARNING CENTER ADDITION AND RENOVATION

1 20 A

2496 2 20 A N ECH-2

AD-03 1 20 A -- SPARE

0 A | 1 | 400 |

20 A 1 978

20 A 1 240

20 A 1

-- 20 A 1 0

| -- | -- | 1 |

REMARKS: GC = PROVIDE GFI CIRCUIT BREAKER ST = PROVIDE SHUNT TRIP BREAKER LO = PROVIDE LOCKABLE DEVICE N = NEW DEVICE IN EXISTING PANEL

21 WOMENS RR RECEPT

29 EXTERIOR LIGHTING

23 LIGHTING

25 LIGHTING

27 LIGHTING

31 SPACE

33 SPARE

35 SPARE 37 SPARE

39 SPACE

PANEL TOTALS TOTAL CONNECTED LOAD PHASE A: 14202 VA TOTAL CONNECTED LOAD PHASE B: 14011 VA TOTAL CONNECTED LOAD PHASE C: 0 VA TOTAL CONNECTED LOAD: 28213 VA REFER TO SPECIFICATIONS FOR ADDITIONAL INFORMATION TOTAL CONNECTED AMPS: 118 A

2496

-- 20 A 1 0 0 1 20 A -- SPARE
-- 20 A 1 0 0 1 0 A -- SPARE
-- 1 1 -- 1 SPACE

EX B-2 LOCATION: MECHANICAL/... **VOLTS:** 120/240 Single SUPPLY FROM: EX B PHASES: MOUNTING: RECESSED MAINS TYPE: MCB ENCLOSURE: NEMA-1 MAIN RATING: 125 A **A.I.C. RATING**: 22000 A BUSSING: COPPER NOTES:

СКТ	CIRCUIT DESCRIPTION	LEG.	TRIP	POLES	Α	В	Α	В	POLES	TRIP	LEG.	CIRCUIT DESCRIPTION	СКТ
1	- WS-1		20 A	2	240				1			SPACE	2
3	- WS-1		20 A	2		240			1			SPACE	4
5	AC/CU-1		20 A	2	1664		500		1	20 A		FACP	6
7	AC/CU-1		20 A	2		1664		250	1	20 A		RCP-1	8
9	IT RACK		30 A	1	200		600			20.4		WH-1	10
11	SPARE		20 A	1		0		600	2	20 A		VVII- I	12
13	SPARE		20 A	1	0		0		1	20 A		SPARE	14
15	SPARE		20 A	1		0		0	1	20 A		SPARE	16
17	SPARE		20 A	1	0		0		1	2 A		SPARE	18
19	SPARE		20 A	1		0		0	1	20 A		SPARE	20
21	SPACE			1					1			SPACE	22
23	SPACE			1					1			SPACE	24
25	SPACE			1					1			SPACE	26
27	SPACE			1					1			SPACE	28
29	SPACE			1					1			SPACE	30
31	SPACE			1					1			SPACE	32
33	SPACE			1					1			SPACE	34
35	SPACE			1					1			SPACE	36
37	SPACE			1					1			SPACE	38
39	SPACE			1					1			SPACE	40

REMARKS: GC = PROVIDE GFI CIRCUIT BREAKER ST = PROVIDE SHUNT TRIP BREAKER LO = PROVIDE LOCKABLE DEVICE N = NEW DEVICE IN EXISTING PANEL

PANEL TOTALS TOTAL CONNECTED LOAD PHASE A: 3204 VA TOTAL CONNECTED LOAD PHASE B: 2754 VA TOTAL CONNECTED LOAD PHASE C: 0 VA TOTAL CONNECTED LOAD: 5958 VA REFER TO SPECIFICATIONS FOR ADDITIONAL INFORMATION TOTAL CONNECTED AMPS: 25 A

EX B

LOCATION: MECHANICAL/.. 120/240 Single VOLTS: SUPPLY FROM: MDP PHASES: MOUNTING: RECESSED MAINS TYPE: MLO **ENCLOSURE**: NEMA-1 MAIN RATING: 200 A **A.I.C. RATING**: 100,000 A BUSSING: COPPER NOTES:

CKT CIRCUIT DESCRIPTION LEG. TRIP POLES A B A B POLES TRIP LEG. CIRCUIT DESCRIPTION CKT 1 CLASSRM A-133 RECPT 20 A 1 1400 900 1 20 A CLASSRM A-133 RECPT CLASSRM A-115 RECPT N 20 A 1 900 1200 1 20 A 5 CLASSRM A-132 RECPT CLASSRM A-115 RECPT CLASSRM A-132 RECPT 20 A 1 1 20 A CLASSRM A-117 RECPT 9 CLASSRM A-130 RECPT CLASSRM A-117 RECPT 11 CLASSRM A-130 RECPT 1070 1 20 A 1070 -- 30 A 2 EX SPARE EX SPARE -- 40 A 2 21 SPARE 23 SPARE 25 SPARE -- 0 A 1 0 -- 0 A 1 0 0 1 0 A -- SPARE
-- -- 1 -- SPACE 1290 --- 360 --- 1 20 A ACCESS CONTROLS 30 --- 1 20 A SPARE SPARE 29 SPACE -- - 1 -- SPACE
-- - 1 -- - 1 -- -- SPACE
-- - 1 -- - 1 -- -- SPACE
-- - 1 -- - 1 -- -- SPACE

125 A 2 3204 -- 1 -- SPACE
2754 -- 1 -- SPACE 31 SPACE 33 SPACE 35 SPACE EXISTING PANEL B-2 VIA ATS

> GC = PROVIDE GFI CIRCUIT BREAKER ST = PROVIDE SHUNT TRIP BREAKER O = PROVIDE LOCKABLE DEVICE I = NEW DEVICE IN EXISTING PANEL

LO = PROVIDE LOCKABLE DEVICE

N = NEW DEVICE IN EXISTING PANEL

REFER TO SPECIFICATIONS FOR ADDITIONAL INFORMATION

PANEL TOTALS TOTAL CONNECTED LOAD PHASE A: 9974 VA TOTAL CONNECTED LOAD PHASE B: 10709 VA TOTAL CONNECTED LOAD PHASE C: 0 VA 20683 VA TOTAL CONNECTED LOAD: REFER TO SPECIFICATIONS FOR ADDITIONAL INFORMATION TOTAL CONNECTED AMPS: 86 A

NEW D LOCATION: MECHANICAL/... VOLTS: 120/208 Wye SUPPLY FROM: PHASES: MOUNTING: SURFACE MAINS TYPE: MLO **ENCLOSURE**: NEMA-1 MAIN RATING: 225 A **A.I.C. RATING**: 100,000 BUSSING: COPPER NOTES: CKT | CIRCUIT DESCRIPTION | LEG. | TRIP | POLES | A | B | C | A | B | C | POLES | TRIP | LEG. | CIRCUIT DESCRIPTION | CKT 20 A 1 3000 2500 1 20 A VAV-1D 20 A 1 2500 3000 1 20 A VAV-1E 5 VAV-1C 2000 1 20 A 20 A 1 4500 VAV-1F 1 25 A 7 VAV-1G 25 A 1 3500 VAV-1J 3500 3500 9 VAV-1H 3500 25 A 1 1 25 A VAV-1K 11 VAV-1I 3500 1500 1 20 A VAV-1L 25 A 1 13 VAV-1M 20 A 1 3500 1981 15 VAV-1N 30 A 1 3 100 A DBP-1 4500 1981 17 VAV-10 25 A 1 1981 4000 4996 21 ROOF RECEPT 3 60 A RT-2 20 A 1 200 4996 21256 4996 25 RTU-1 225 A 3 21256 21256 REMARKS: GC = PROVIDE GFI CIRCUIT BREAKER ST = PROVIDE SHUNT TRIP BREAKER

PANEL TOTALS

133399 VA

370 A

TOTAL CONNECTED LOAD PHASE A: 44233 VA

TOTAL CONNECTED LOAD PHASE B: 45433 VA

TOTAL CONNECTED LOAD PHASE C: 43733 VA

TOTAL CONNECTED LOAD:

TOTAL CONNECTED AMPS:

EX C

LOCATION: MECHANICAL/... **VOLTS:** 120/240 Single SUPPLY FROM: MDP PHASES: MOUNTING: RECESSED MAINS TYPE: MLO **ENCLOSURE**: NEMA-1 MAIN RATING: 200 A **A.I.C. RATING:** 100,000 A BUSSING: COPPER NOTES:

СКТ	CIRCUIT DESCRIPTION	LEG.	TRIP	POLES	Α	В	Α	В	POLES	TRIP	LEG.	CIRCUIT DESCRIPTION	СКТ
1	RECEPTION RECEPT	N	20 A	1	600		600		1	20 A		CONF RM RECEPT	2
3	RECEPTION TV		20 A	1		500		400	1	20 A		CONF RM TV	4
5	OFFICE A-106 TV	N	20 A	1	900		600		1	20 A		SGI RECEPT	6
7	OFFICE A-106 RECEPT		20 A	1		600		2400	1	20 A		MAIN ENTRANCE	8
9	OFFICE A-107 TV	N	20 A	1	900		0		1	20 A		CARD READER	10
11	OFFICE A-107 RECEPT	N	20 A	1		400		600	1	20 A	N	FRONT RECEPT	12
13	MECH RM RECEPT		20 A	1	200		800		1	20 A	N	BREAKRM FRIDGE	14
15	MEN'S RR HAND DRYER		20 A	1		1900		200	1	20 A	N	BREAKRM DISHWASHER	16
17	RESTROOM RECEPT		20 A	1	600		800		1	20 A		FOOD WARMER	18
19	DECEDION CODIED		40.4	0		2800		800	1	20 A		FOOD WARMER	20
21	- RECEPTION COPIER		40 A	2	2800		800		1	20 A		FOOD WARMER	22
23	WOMEN'S RR HAND DRYER	N	20 A	1		1900		800	1	20 A	N	BREAKRM RECEPT	24
25	EWC	N	20 A	1	200		1134		1	20 A	N	LIGHTING	26
27	CLINIC FRIDGE	N	20 A	1		800		942	1	20 A	N	LIGHTING	28
29	CLINIC RR HAND DRYER	N	20 A	1	1900		10		1	20 A		EXIT SIGNS	30
31	CLINIC RECEPT	N	20 A	1		1200		4000		20.4	N	TCIL 1	32
33	RECEPT		20 A	1	600		0		2	20 A	N	ECH-1	34
35	CLINIC TABLES		20 A	1		400		0	1	20 A		SPARE	36
37	SPACE			1					1			SPACE	38
39	SPACE			1					1			SPACE	40

GC = PROVIDE GFI CIRCUIT BREAKER ST = PROVIDE SHUNT TRIP BREAKER LO = PROVIDE LOCKABLE DEVICE N = NEW DEVICE IN EXISTING PANEL

PANEL TOTALS TOTAL CONNECTED LOAD PHASE A: 13443 VA TOTAL CONNECTED LOAD PHASE B: 20640 VA TOTAL CONNECTED LOAD PHASE C: 0 VA TOTAL CONNECTED LOAD: 34083 VA REFER TO SPECIFICATIONS FOR ADDITIONAL INFORMATION TOTAL CONNECTED AMPS: 142 A

GIBRALTAR DESIGN ARCHITECTURE • ENGINEERING • INTERIOR DESIGN



PROJECT:

ALTERNATIVE LEARNING CENTER ADDITION AND RENOVATION

Tippecanoe School Corporation

2241 Old Romney Rd, Lafayette, IN

GIBRALTAR DESIGN

9102 N. Meridian St., Ste. 300 Indianapolis, IN 46260 Homepage: www.GibraltarDesign.com Email: info@GibraltarDesign.com Phone 317.580.5777 Fax 317.580.5778

23-148 DATE 07/09/2025 **COORDINATED BY** DRAWN BY CHECKED BY

PROJECT



COPYRIGHT NOTICE: THE CONCEPTS, DESIGNS, PLANS, DETAILS, ETC, SHOWN ON THIS DOCUMENT ARE THE PROPERTY OF GIBRALTAR DESIGN AND WERE CREATED FOR USE ON THIS SPECIFIC PROJECT. NONE OF THIS INFORMATION SHALL BE USED BY ANY PERSON OR FIRM FOR ANY PURPOSE WITHOUT THE EXPRESS WRITTEN CONSENT OF GIBRALTAR DESIGN. THE OWNER MAY RETAIN COPIES FOR INFORMATION AND REFERENCE IN CONNECTION ONLY WITH THIS PROJECT.

REVISIONS MARK DATE ISSUED FOR

AD-01 07/23/25 ADDENDUM NO. AD-02 07/30/25 ADDENDUM NO. 2 AD-03 08/01/25 ADDENDUM NO. 3

ELECTRICAL SCHEDULES

ALTERNATIVE LEARNING CENTER ADDITION AND RENOVATION